


DATE _____

TOWN OF LEXINGTON — BOARD OF PUBLIC WORKS SEWER DIVISION

Sketch of Service Here **21**

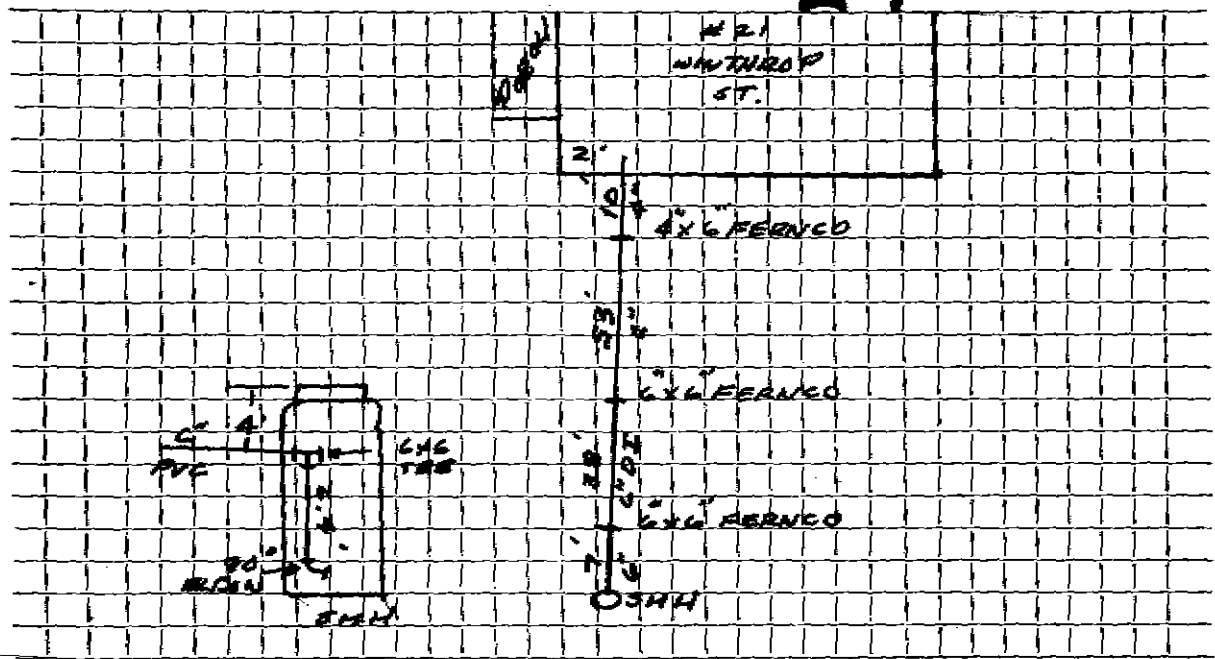

Connection made in WINTHROP Street. Work completed

Remarks: DROP INSIDE SMH.

38 LF 6" CLO I @ ST. X-ING