

Name Louis J. Ferracane

Service No. 25

Address 31 Winthrop Road

Lexington 31 Winthrop Road Location

Kind of Pipe

Size 6"

Size of Main 8"

~~REPLACEMENT~~ New Service

COM. 4-27-53

Location

Date	Material	Amount	Total	Date	Amount
4/7/53	Labor	68 99		3-11-53	Deposited 150 -
4/8/53	"	28 05	97 04	6-25-53	Paid (16 74)
	10% overhead		9 70		166 74
	70' - 5" transite pipe @ .55		38 50		
	4 hrs. town shovel @ 5.00		20 00		
	2 hrs. trucking @ .75		1 50		
			<u>166 74</u>		
	Labor			8/18/68	Wt something paid

**TOWN OF LEXINGTON—DEPT. OF PUBLIC WORKS
SEWER DIVISION**

DATE.....

NO.


The undersigned applies for the construction of a particular sewer connecting No.....
Street and hereby agrees to comply with the Rules and Regulations governing the construction and use of Particular
Sewers, as now or at any future time established by the Board of Selectmen.

Am't of estimate \$.....

Am't Paid \$.....

..... Owner

Sketch of Service Here

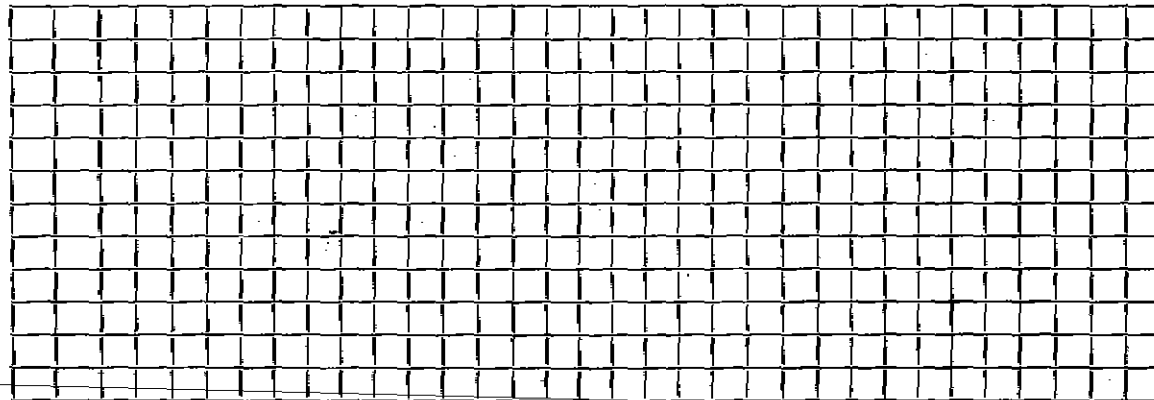

Connection made in

Street.

Work completed

19..

Remarks: