

Name Eleanor P. Dow

Service No. 119

Address 36 Winthrop Road

36 Winthrop Road

Location

Comm. 11-19-56

Kind of Pipe

Size 6"

Size of Main 8"

~~Repair~~ New Service

Location

Date	Material	Amount	Total	Date	Amount
8/25/56	Labor	59 37		8-24-56	Deposit \$ 200 00
	10% overhead	5 94	65 31	11-19-56	Refund 41 01
	56' - 6" Sewer pipe @ .455		25 48		158 99
	Joint compound		3 36		
	6 2/3 hrs. Littlefield Shovel @		63 34		
	2 hrs. trucking @ .75	9 50	1 50		
			158 99		
	Labor				

TOWN OF LEXINGTON—DEPT. OF PUBLIC WORKS  
**SEWER DIVISION**

DATE .....

NO. ....


The undersigned applies for the construction of a particular sewer connecting No. ....  
Street and hereby agrees to comply with the Rules and Regulations governing the construction and use of Particular  
Sewers, as now or at any future time established by the Board of Selectmen.

Am't of estimate \$.....

Am't Paid \$.....

..... Owner

Sketch of Service Here **36**

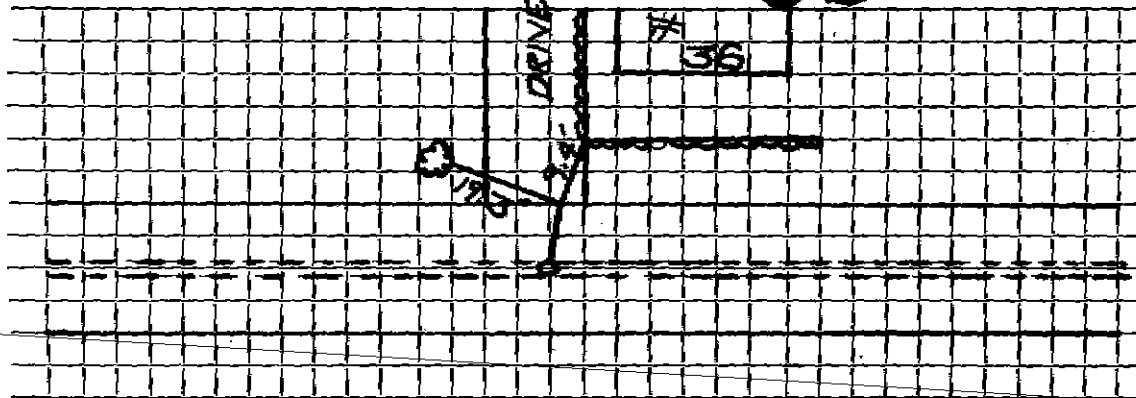

Connection made in ..... Street.

Work completed ..... 19..

Remarks: