

Name Foley Const.

Service No. 6

Address 37 Wintthrop Road

Lot #53 Sta. 1+60 Right

Location

Kind of Pipe DeFlice Bros Permit #A175

Size 6"

Size of Main 8" 1966

~~Repair - Renewal~~ - New Service

Location


MAY 2

Date	Material	Amount	Total	Date	Amount
7-18-62	Labor	36.49		2-11-66	80.37
	10% O.H.	3.65	40.14		
22'	6" Transite pipe @.78		17.16		
1	90° Transite Elbow		4.09		
2	hrs. Town Shovel @6.50		13.00		
2	hrs. Trucking @3.00		6.00		
	BILL WHEN CONNECTED		80.37		
3-8-66	44' 6" Transite pipe				

DATE _____

TOWN OF LEXINGTON — BOARD OF PUBLIC WORKS
SEWER DIVISION

Sketch of Service Here **37**

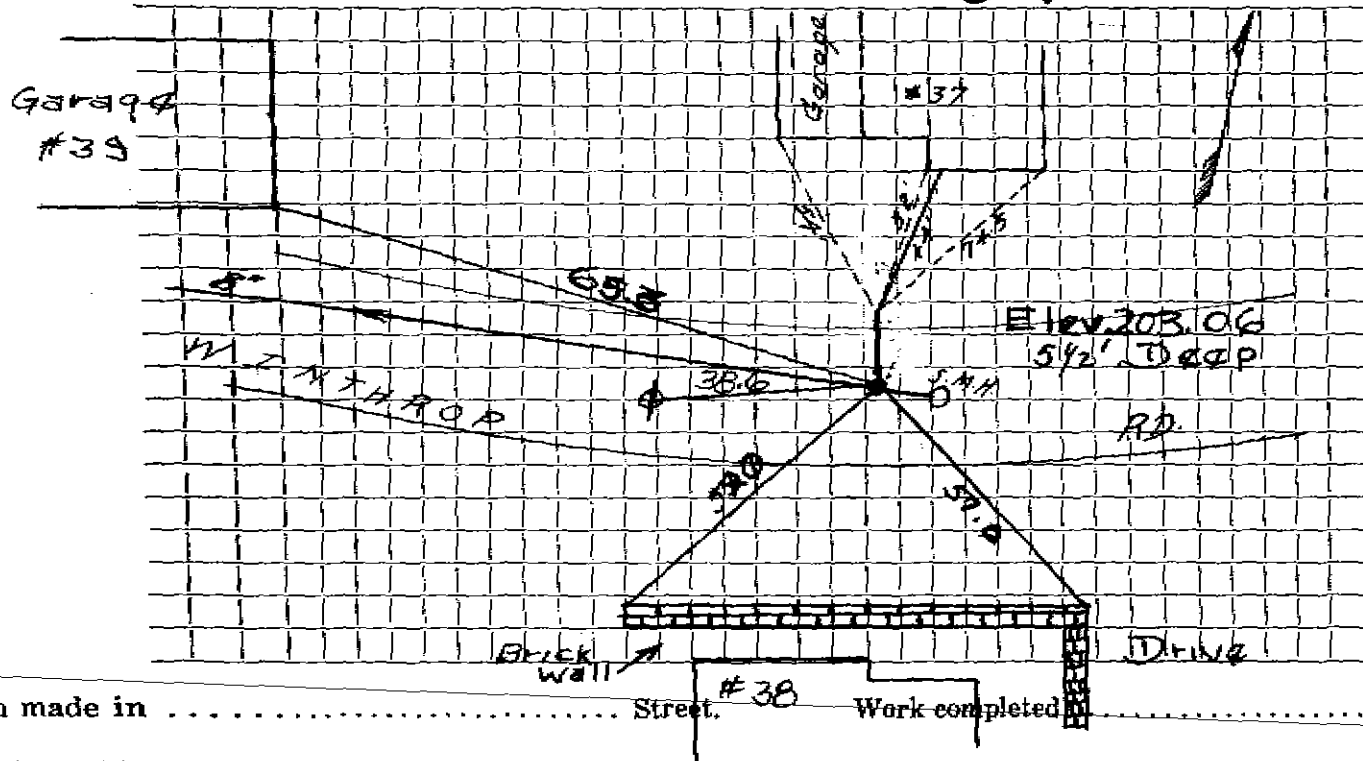

Connection made in Street. #38 Work completed in

Remarks:

.....

.....