

Name John W. Drake

Service No. 120

Address 39 Winthrop Road

39 Winthrop Road

Location

Kind of Pipe

Size 6"

Size of Main 8"

~~REPLACEMENT~~ New Service

Location Comm 11-13-61

Date	Material	Amount	Total	Date	Amount
9/22/61	Labor	74 84		9-12-61	Deposit 200 00
	10% O.H.	7 48	82 32	11-13-61	Refund 39 56
	54' 6" Transite Pipe @ 78		42 12		160 44
	6 Hrs. Town Shovel @ 5.00		30.00		
	2 Hrs. Trucking @ 3.00		6 00		
			160 44		
	Labor				

**TOWN OF LEXINGTON—DEPT. OF PUBLIC WORKS
SEWER DIVISION**

DATE.....

NO.

The undersigned applies for the construction of a particular sewer connecting No.....
Street and hereby agrees to comply with the Rules and Regulations governing the construction and use of Particular
Sewers, as now or at any future time established by the Board of Selectmen.


Am't of estimate \$.....

Am't Paid \$.....

..... Owner

Sketch of Service Here

39

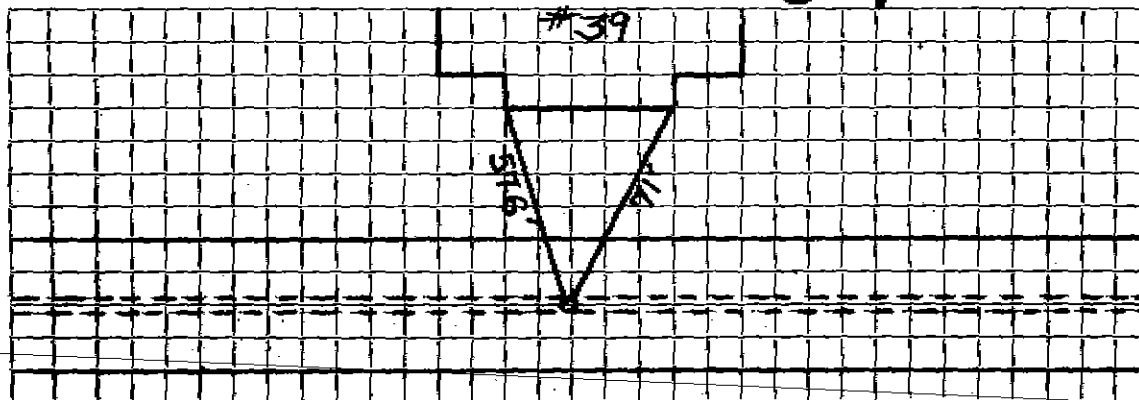

Connection made in Street.

Work completed.....19..

Remarks: