

Name Harris Lawless

Service No. 165

Address 42 Winthrop Road

42 WINTHROP ROAD

Location

Kind of Pipe

Size 6"

Size of Main 8"

~~Repair~~ ~~Renewal~~ New ServiceLocation *Corner 10-24-60*

Date	Material	Amount	Total	Date	Amount
9-8-60	Labor 41.84			8-26-60	Deposit 300.00
9-9-60	" 14.86	56.70		10-24-60	Retard 123.27
	10% O.H.	5.67	62.37		126.23
	62' 6" Transite pipe @.78		48.36		
	1 hr. Trucking @3.00		3.00		
	2 hrs. Town Shovel @6.50		13.00	3-30-64	L.O. 16.35
			126.73		
				3-30-64	SEWER MAIN NOT CLEAN AFTER WATER MAIN BREAK
	Labor			10/17/68	Pipes stopped up with paper

TOWN OF LEXINGTON—DEPT. OF PUBLIC WORKS
SEWER DIVISION

DATE.....

NO.


The undersigned applies for the construction of a particular sewer connecting No.....
Street and hereby agrees to comply with the Rules and Regulations governing the construction and use of Particular
Sewers, as now or at any future time established by the Board of Selectmen.

Am't of estimate \$.....

Am't Paid \$.....

..... Owner

Sketch of Service Here **42**

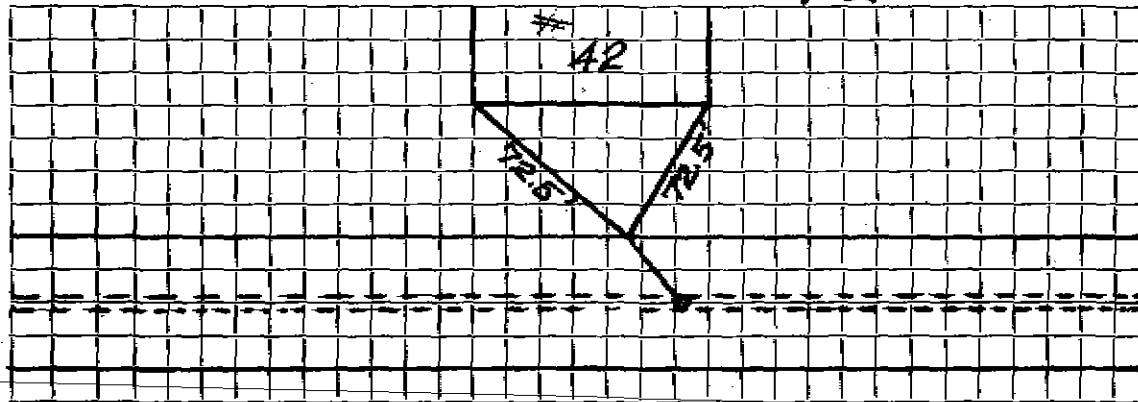

Connection made in

Street.

Work completed.....19..

Remarks: