


DATE Nov 18, 1983

TOWN OF LEXINGTON — BOARD OF PUBLIC WORKS
SEWER DIVISION

Sketch of Service Here 4 4

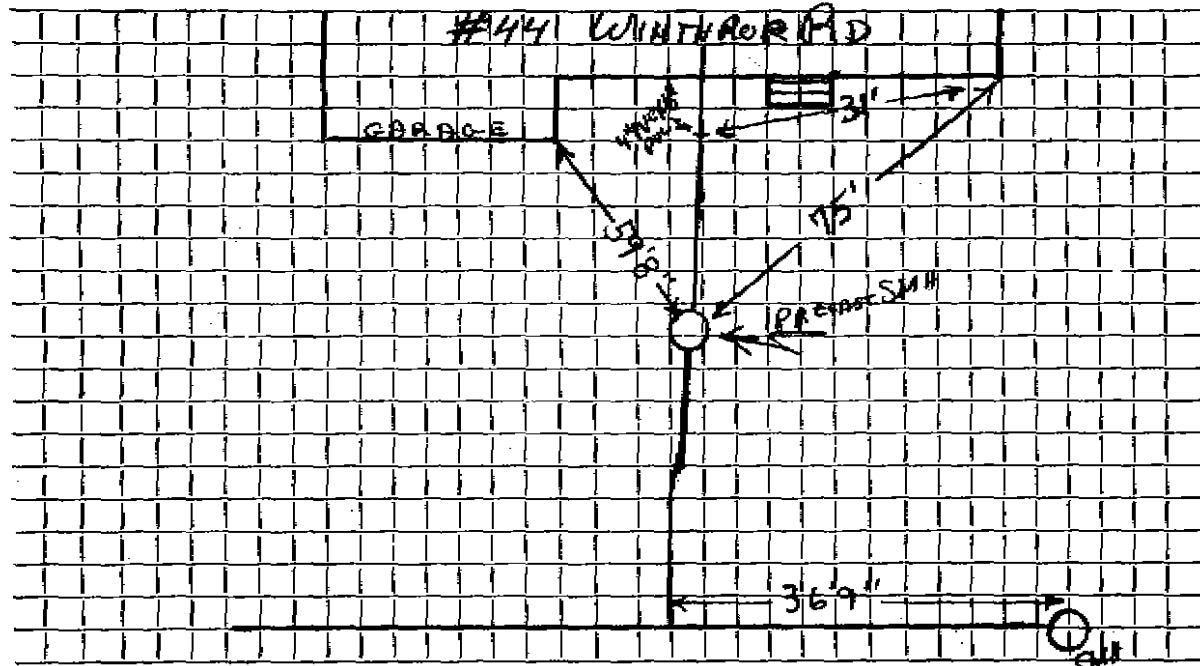

Connection made in WINTHROP RD Street. Work completed Nov 18, 1983

Remarks:

.....

.....