

Name Hugo Anderson

Service No. 53

Address 45 Winthrop Road

Location

45 Winthrop Road

Kind of Pipe

Size 6"

Size of Main 8"

REPAIRS-NEW SERVICE

Location

1-19-61

Date	Material	Amount	Total	Date	Amount
5-26-61	Labor	48.57		5-23-61	200.00
5-27-61	Labor	19.02	97.59	6-15-61	11.13
	10% O.H.		9.74		211.63
	60' 6" sewer pipe @.78		46.80		
	8 Ton 3/4"		9.99		
	1 1 1/2" Transitite Band		5.10		
	1 90° Transite Elbow		6.40		
	3 Exc. Town Shovel	26.50	19.50		
	3 Exc. Traveling	25.00	9.00		
	4 Exc. Sampling	21.00	4.00		
	1 Hr. Trailer	25.00	5.90		
	1 Hr. Loader	25.00	3.90		
			211.63		


Deposit Paid by W.H. Anderson

DATE \_\_\_\_\_

**TOWN OF LEXINGTON — BOARD OF PUBLIC WORKS**

**SEWER DIVISION**

Sketch of Service Here

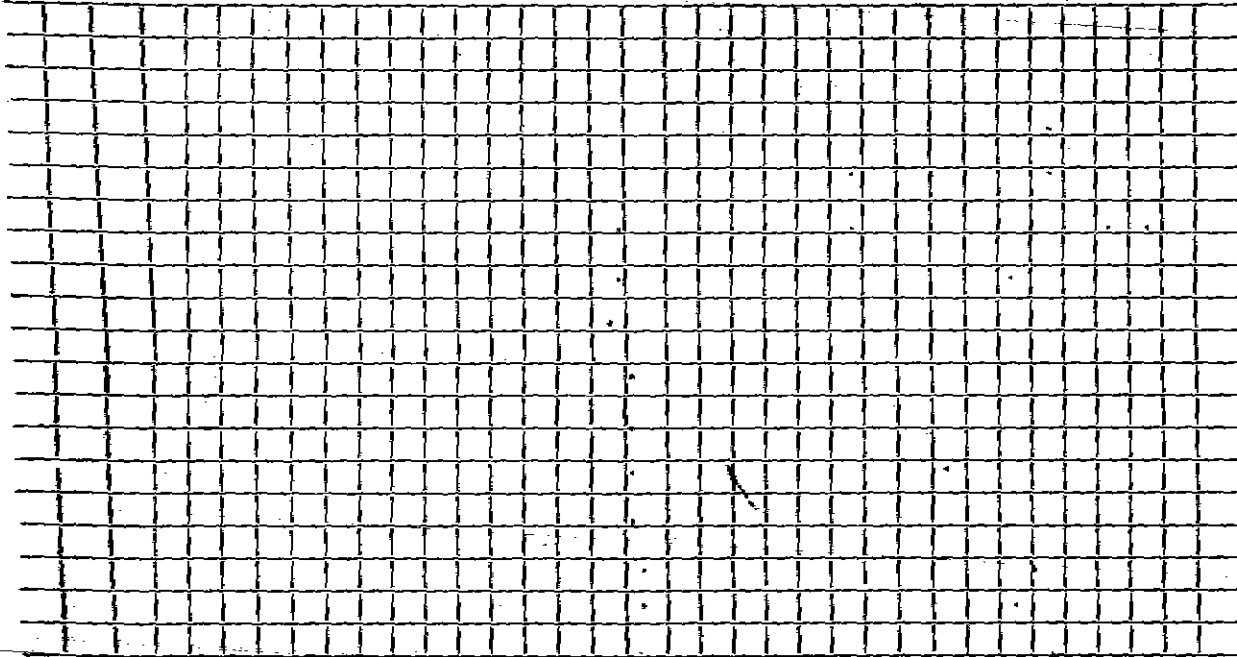

Connection made in ..... Street. Work completed .....

Remarks: .....

.....

.....