

Name Dr. Edward Anderson

Service No. 72

Address 47 Winthrop Road

Lot 225 47 Winthrop Rd. Location

Kind of Pipe

Size 6"

Size of Main 8"


Repair—Renewal—New Service Lucente #1424

Location SEP 2 1969

Date	Material	Amount	Total	Date	Amount
7-19-62	Labor	19.04		7-24-69	64.31
	10% O.H.	1.90	20.94		
	26' 6" Transite pipe @.78		20.28		
	1 90° Transite Elbow		4.09		
	2 hrs. Town Shovel @6.50		13.00		
	1 hr. Trucking @3.00		3.00		
	1 hrs. Loader @3.00		3.00		
	BILL WHEN CONNECTED		64.31		
8-4-69	104' 6" Transite pipe				
	15' 4" Cast Iron Pipe				

DATE \_\_\_\_\_

TOWN OF LEXINGTON — BOARD OF PUBLIC WORKS  
SEWER DIVISION

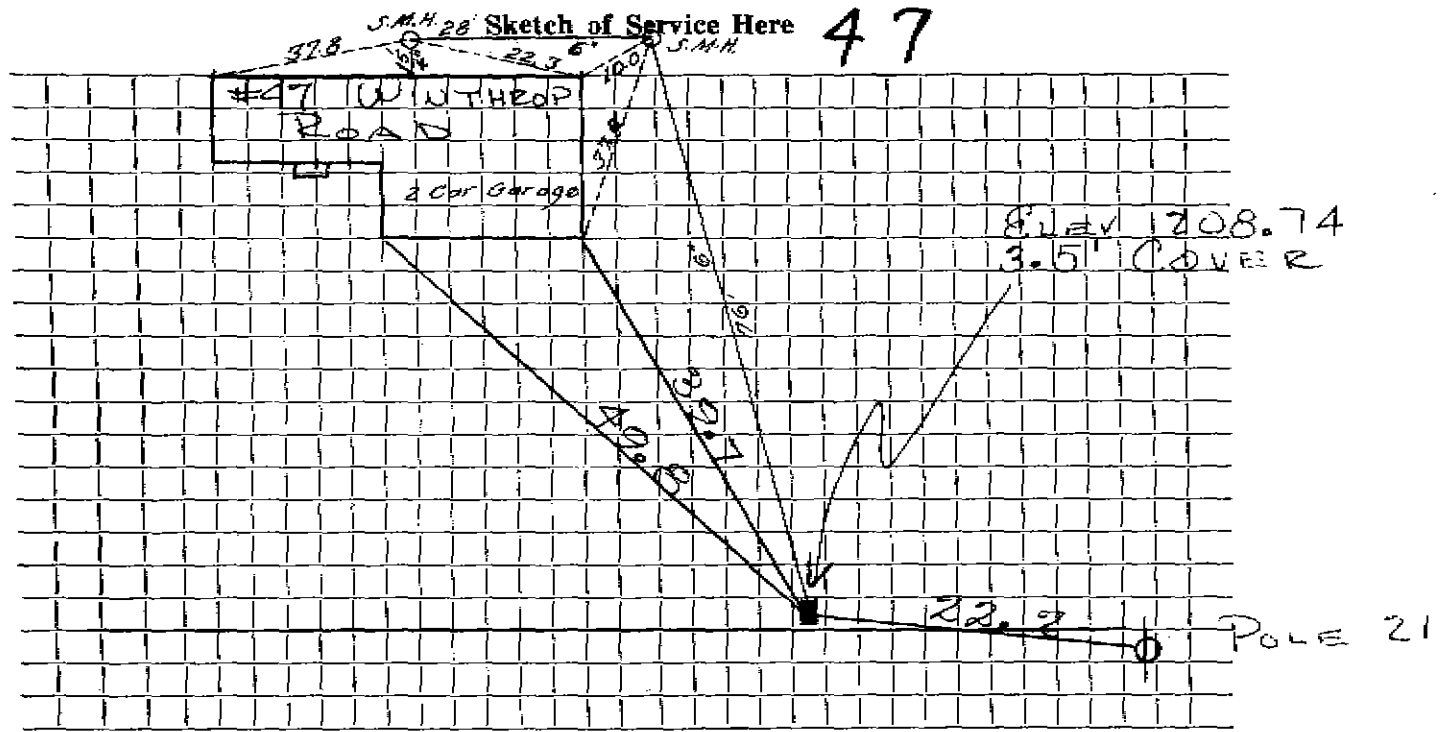

Connection made in ..... Street. Work completed .....

Remarks: .....  
.....  
.....