

Name Stanley Phalen

Service No. 25

Address 148 Winthrop Road

Lexington, Mass.

Location 148 Winthrop Road

Size 6"

Size of Main 8"

Begin-Break New Service Com. 8-6-51

Location

Date	Material	Amount	Total
4-14-51	Labor	36.88	
6-28-51	Labor	15.44	52.32
	10% Overhead		5.23
	50' - 6" Sewer Pipe @ .36		18.00
	Joint Compound		3.00
	Littlefield Shovel 6 hrs @ 7.00		42.00
	Trucking 2 hrs. @ .75		1.50
			122.05

Date	Material	Amount	Total
4-14-51	Labor	36.88	
6-28-51	Labor	15.44	52.32
	10% Overhead		5.23
	50' - 6" Sewer Pipe @ .36		18.00
	Joint Compound		3.00
	Littlefield Shovel 6 hrs @ 7.00		42.00
	Trucking 2 hrs. @ .75		1.50
			122.05

Phalen  
Sewer  
Main  
148 Winthrop Road

Labor

**TOWN OF LEXINGTON—DEPT. OF PUBLIC WORKS**  
**SEWER DIVISION**

**DATE** .....

**NO.** .....


The undersigned applies for the construction of a particular sewer connecting No. ....  
Street and hereby agrees to comply with the Rules and Regulations governing the construction and use of Particular  
Sewers, as now or at any future time established by the Board of Selectmen.

**Am't of estimate \$** .....

**Am't Paid \$** .....

..... **Owner**

**Sketch of Service Here**

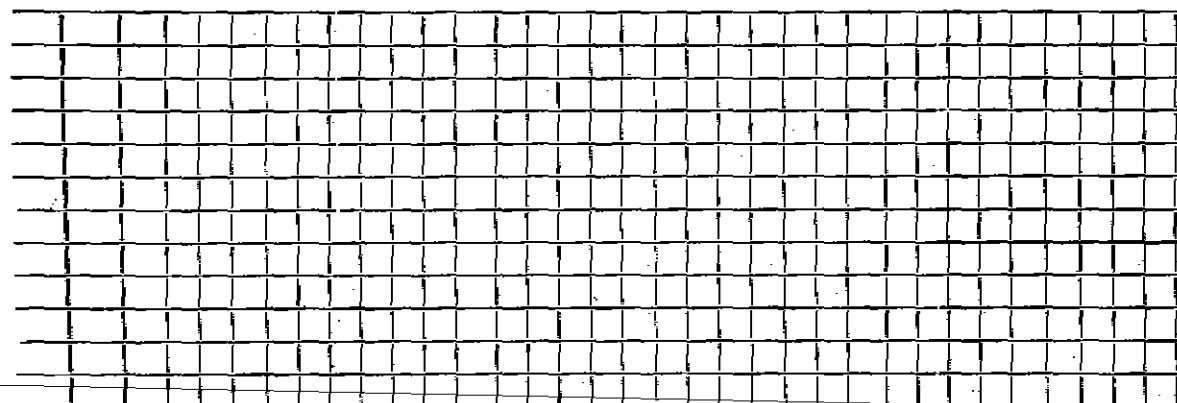

**Connection made in** ..... Street.

**Work completed** ..... 19..

**Remarks:**