

Name Moore Homes Inc.

Service No. 171

Address 52 Winthrop Road

Lot 168

(VACANT)

Location

Kind of Pipe

Size 6"

Size of Main 8"

Repair—Renewal—New Service DeFlice #860


Location MAY 13 1968

Date	Material	Amount	Total	Date	Amount
7-19-62	Labor	40.95		11-21-67	86.09
	10% O.H.	4.10	45.05		
	20' 6" Transite pipe @.75		15.60		
	1 11 1/2° Transite Elbow		2.35		
	1 90° Transite Elbow		4.09		
	2 hrs. Town Shovel @6.50		13.00		
	1 hr. Trucking @3.00		3.00		
	1 hr. Loader @3.00		3.00		
	BILL WHEN CONNECTED		86.09		
12-19-67	48' 6" Transite pipe				
	10' 4" Cast Iron				

DATE _____

TOWN OF LEXINGTON — BOARD OF PUBLIC WORKS
SEWER DIVISION

Sketch of Service Here **52**

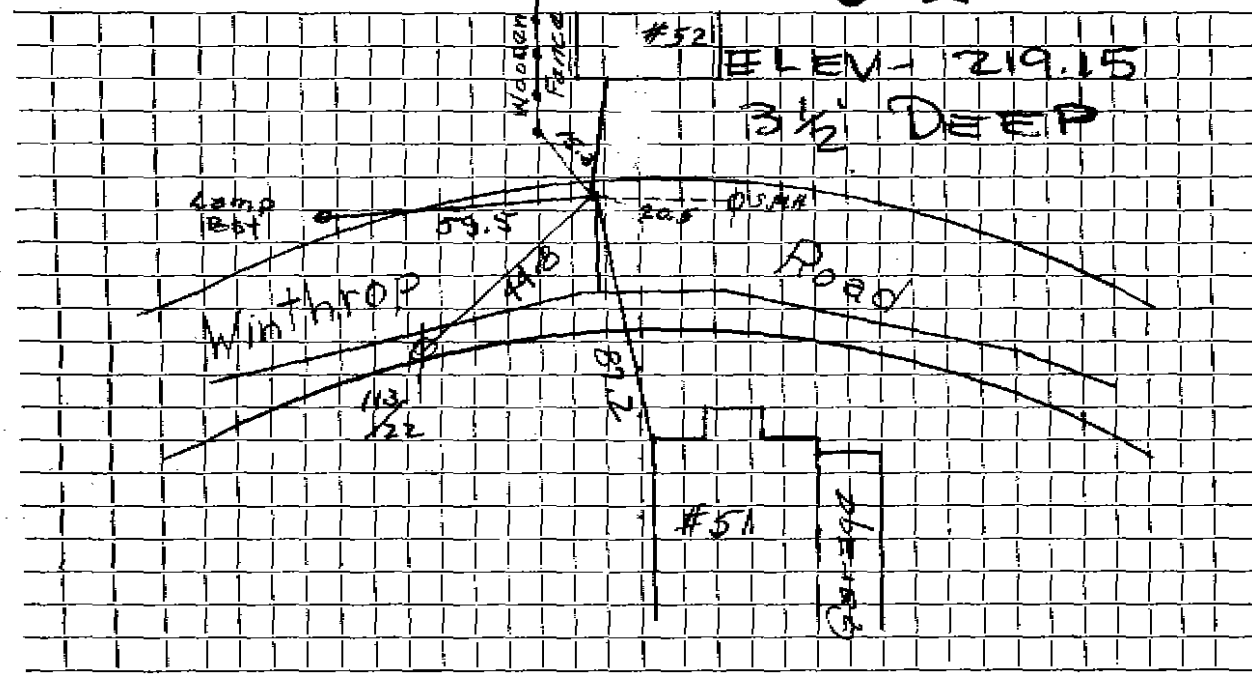

Connection made in Street. Work completed

Remarks:
.....
.....