


DATE July 2001

TOWN OF LEXINGTON — BOARD OF PUBLIC WORKS
SEWER DIVISION

Sketch of Service Here

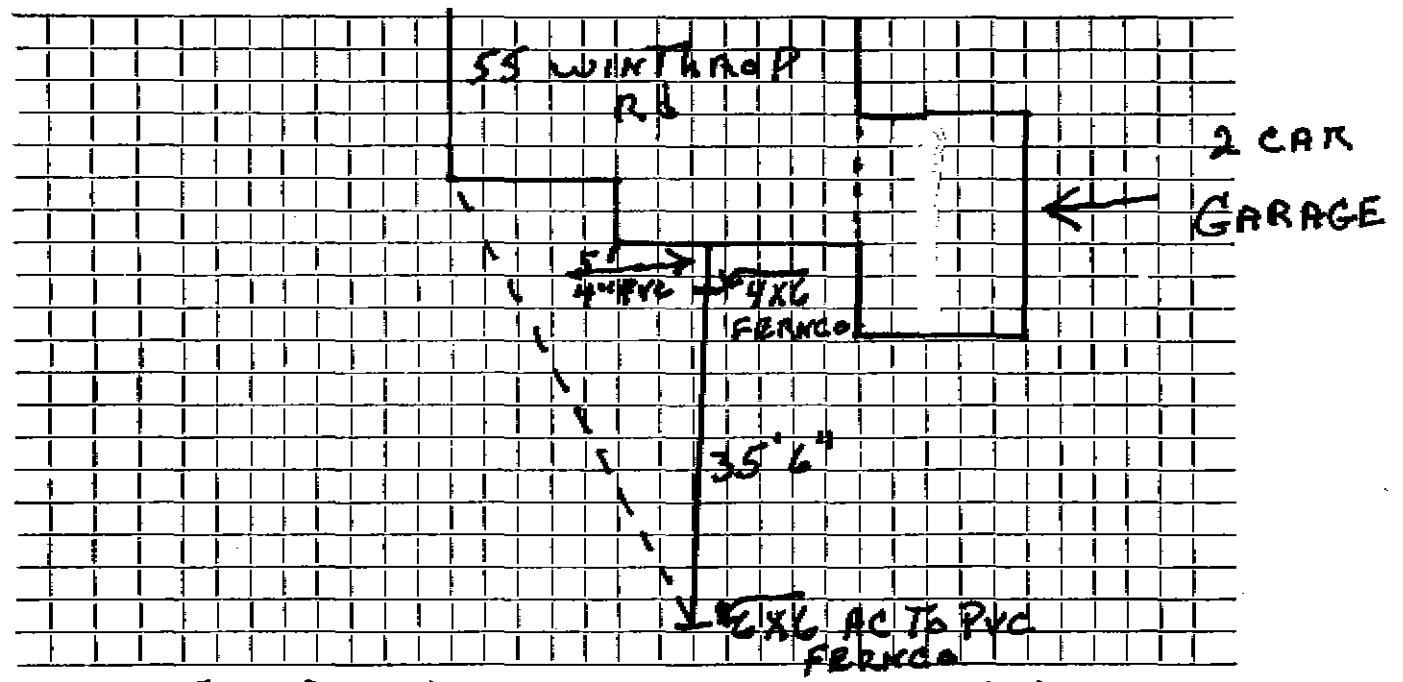

Connection made in WINTHROP Rd... Street. Work completed July 2001.....
Remarks: FN installed by J.M. McLAUGHLIN, INC......