

Name Moore Realty Trust

Service No. 145

Address 6 Winthrop Road

6 Winthrop Road

Location

Kind of Pipe

Size 6"

Size of Main 8"

~~Service Renewal~~ - New Service W.O. #8255

Location Camm 2-10-64


| Date     | Material                  | Amount | Total  | Date     | Amount                                      |
|----------|---------------------------|--------|--------|----------|---|
| 11-15-63 | Labor                     | 102.29 |        | 10-21-63 | Deposit 200.00                              |
|          | 10% O.H.                  | 10.23  | 112.52 | 2-10-64  | Refund 11.08                                |
|          | 45' 6" Transite pipe @.82 |        | 36.90  |          | 188.92                                      |
|          | 1 Bag Cement              |        | 1.50   |          |   |
|          | 4 hrs. Town Shovel @6.50  |        | 26.00  |          |   |
|          | 2 hrs. Trucking @3.00     |        | 6.00   |          |   |
|          | 2 hrs. Loader @3.00       |        | 6.00   |          |   |
|          |                           |        | 188.92 |          |   |
|          |                           |        |        | 57.92    | Roots approx. 60' (Response)<br>(it called) |

DATE \_\_\_\_\_

TOWN OF LEXINGTON — BOARD OF PUBLIC WORKS  
SEWER DIVISION

Sketch of Service Here

6

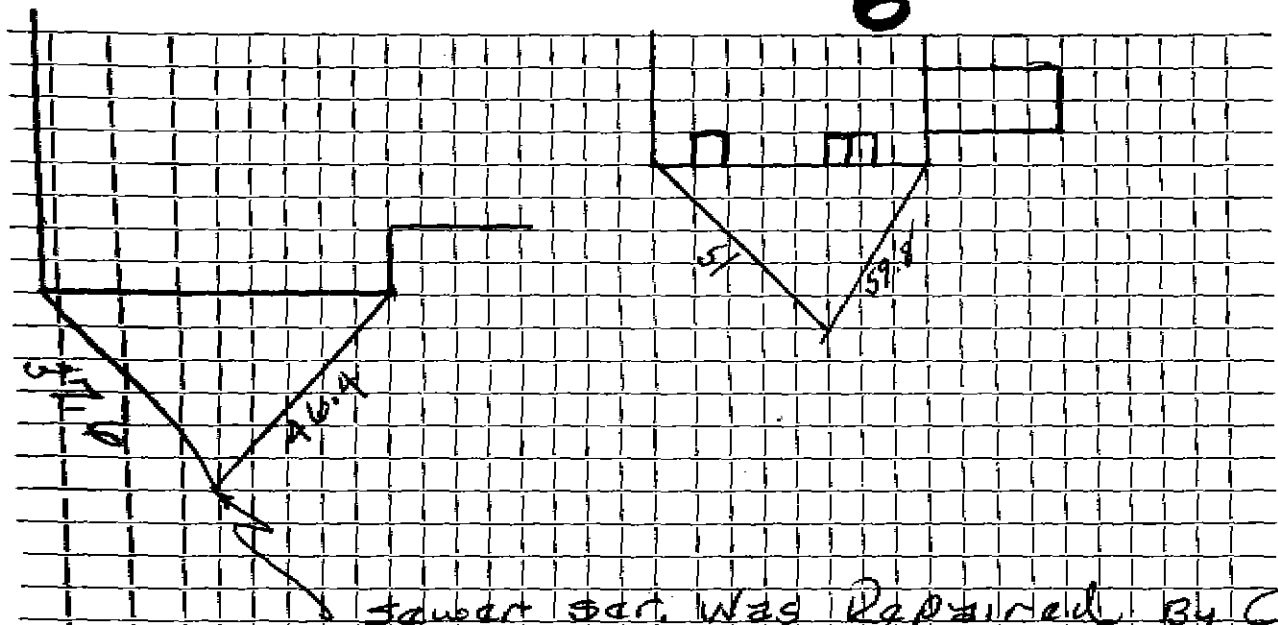

inspected sewer ser. was repaired by Clear Way & Drain Service, Permit # 2454 2-15-74

Connection made in \_\_\_\_\_ Street. Work completed \_\_\_\_\_

Remarks: \_\_\_\_\_  
\_\_\_\_\_  
\_\_\_\_\_