

Name Mrs. Harold H. Hookway

Service No. 16 / 10 6 6

Address ~~378 Massachusetts Avenue, Lexington, Massachusetts~~

9 Winthrop Rd

Location 9 Winthrop Road

Kind of Pipe

Size 6"

Size of Main 8"

~~XXXXXXXXXX~~ New Service

Location

| Date                   | Material                  | Amount | Total  | Date            | Amount    |
|------------------------|---------------------------|--------|--------|-----------------|-----------|
| 11/1/40                | 19 hrs. @.55              | 10 45  |        | October 28 1940 | Deponited |
| <del>11/17-31-40</del> | 76 1/2 hrs. @.60          | 45 90  |        |                 | 7.00      |
|                        | 19 hrs. @.70              | 13 30  | 69 65  |                 |           |
|                        | Overhead 10%              |        | 6 96   |                 |           |
|                        | 46' 6" Sewer Pipe @.16    |        | 7 36   |                 |           |
|                        | Joint Compound            |        | 2 76   |                 |           |
|                        | Compressor, 7 hrs. @3.00  |        | 21 00  |                 |           |
|                        | Tractor, 2 1/2 hrs. @1.78 |        | 4 38   |                 |           |
|                        | Trucking, 4 hrs. @.75     |        | 3 00   |                 |           |
|                        | Patching                  |        | 16 00  |                 |           |
|                        |                           |        | 131 11 |                 |           |
|                        | Charge \$70.00            |        |        |                 |           |
|                        | Labor                     |        |        |                 |           |

TOWN OF LEXINGTON—BOARD OF PUBLIC WORKS  
SEWER DIVISION

DATE October 28, 1940

NO. \_\_\_\_\_


The undersigned applies for the construction of a particular sewer connecting No. 9 Winthrop Rd. Street and hereby agrees to comply with the Rules and Regulations governing the construction and use of Particular Sewers, as now or at any future time established by the Board of Selectmen.

Am't. of Estimate \$ 70.00

Am't. Paid \$ \_\_\_\_\_

Wm. H. Hookway Owner

Sketch of Service Here

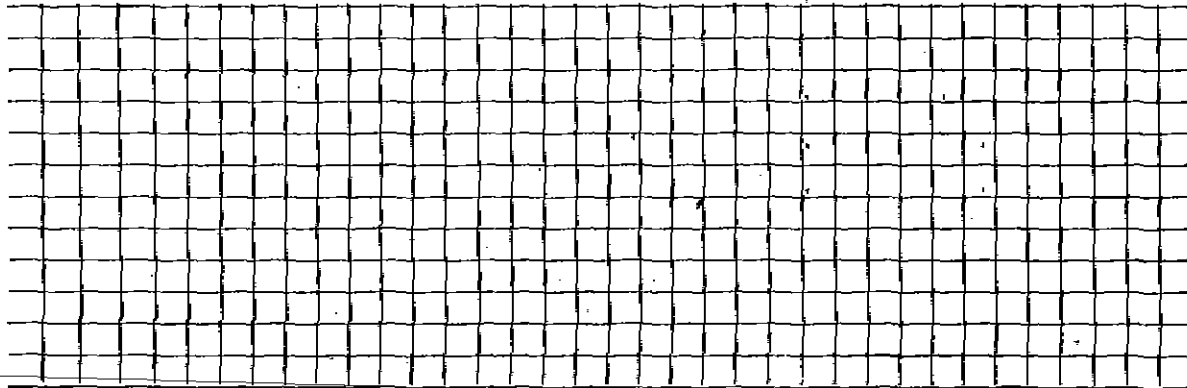

Connection made in \_\_\_\_\_ Street. Work completed \_\_\_\_\_ 19

Remarks: