


DATE _____

TOWN OF LEXINGTON — BOARD OF PUBLIC WORKS
SEWER DIVISION

Sketch of Service Here

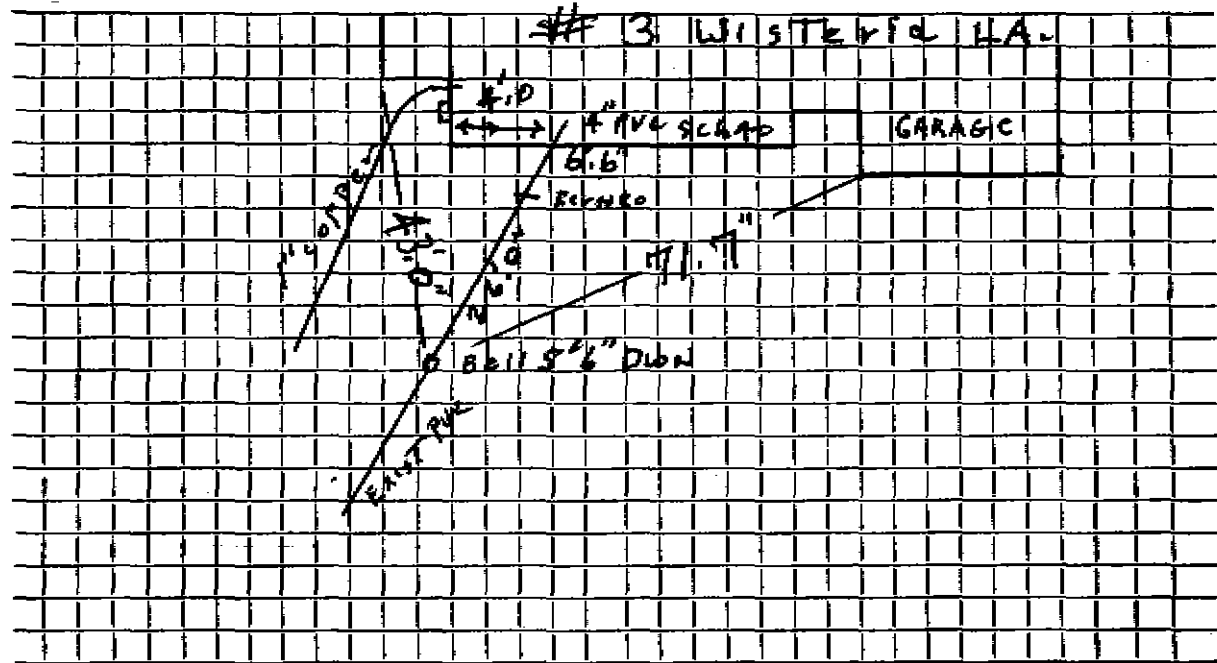

Connection made in Street.

Work completed J. Melangh. 1.12.20... 2/28/20...

Remarks:
.....
.....