


TOWN OF LEXINGTON — BOARD OF PUBLIC WORKS

SEWER DIVISION

DATE _____

Sketch of Service Here

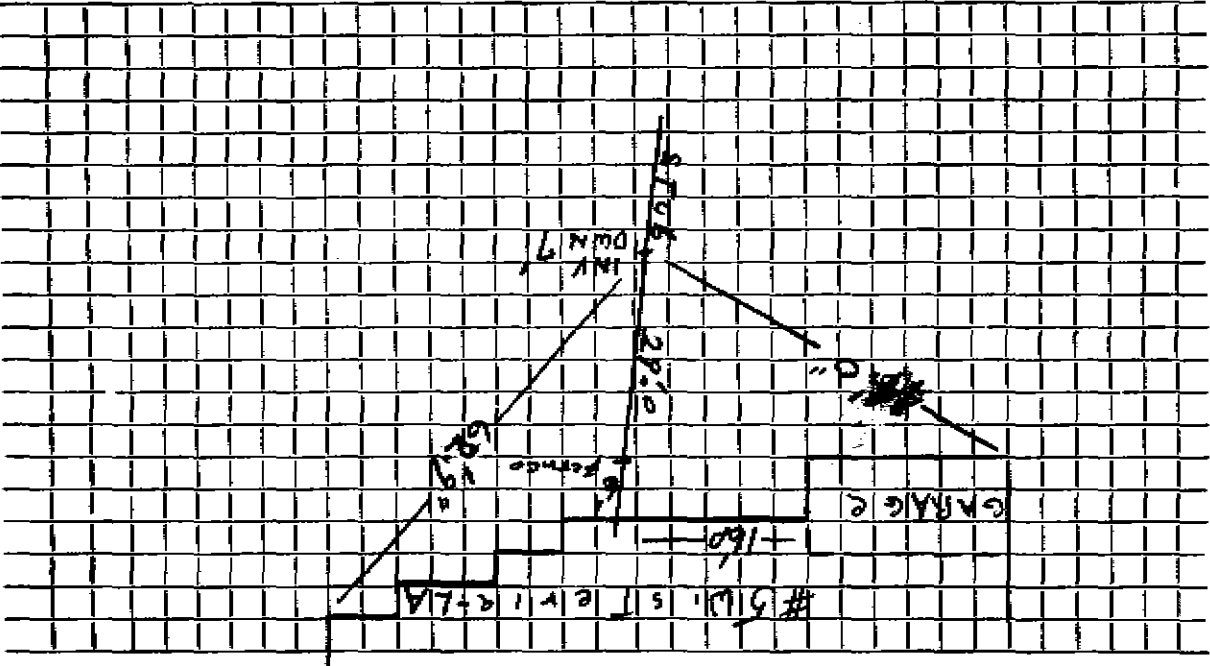

Street

Connection made in

Remarks:

Work completed by Irving Johnson
2003
2006