

Name

Service No. 2397

Address 7 Wisteria LA

Location

LOT 143A

Kind of Pipe PVC

Size 6"

Size of Main

Repair—Renewal—New Service

↓ McLaughlin


Location

Date	Material	Amount	Total	Date	Amount
4/19/07	6' 4" PVC S&L 40				
	40' 6" PVC				
	1 4x6 Ferroc				
	WINO				
	EXIST 6" PVC Sewer ST&H				
	No./In/ft				

DATE _____

TOWN OF LEXINGTON — BOARD OF PUBLIC WORKS
SEWER DIVISION

Sketch of Service Here

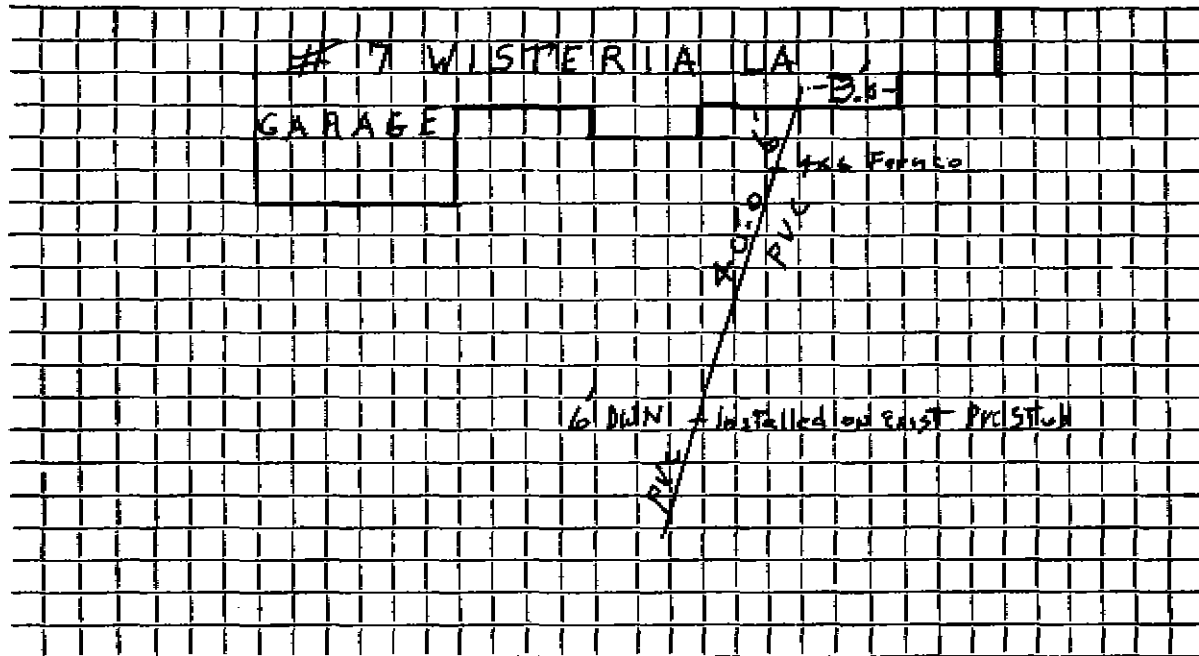

Connection made in Street. Work completed 4/19/07 J. McLaughlin.....

Remarks: 10' dia. - No info.

TOWN OF LEXINGTON — BOARD OF PUBLIC WORKS

SEWER DIVISION

DATE

Sketch of Service Here

A large grid area for sketching service details, consisting of approximately 20 columns and 15 rows of small squares.

WISTERIA LA

Work completed

Street

Connection made in

Remarks:

