

Colonial Beacon Oil Co.

309 North St.  
Biloxi, Miss.

Service No. 100

10 Wolcott St

Location Gasoline Station-corner Fletcher Ave & Wolcott Street.

Kind of Pipe

Size 6"

Size of Main 8"

Character of Work - New Service

Location

Date	Material	Amount	Total	Date	Amount
5/11/38	42 1/2 hrs. @ 55¢	23 38		March 7, 1938	60 00
DOWN 5-10-38	16 " @ 60¢	9 60	32 98		
	10% Overhead		3 29		
	45' 6" Sewer Pipe @ 20¢	9 00			
	1 6" 1/8 Bend		65	DEC 4 1938	TWO 6" CIP VCP FEANCO ADAPTERS 4' X 6" CIP
	1 6 x 4 Reducer		90		
	Jointing compound		2 76		
	3 hrs. trucking @ 75¢	2 25			
	Patching 23' x 3'		6 67		
			<u>50 50</u>		
	Flat Rate:	\$60.00			
	Labor				

TOWN OF LEXINGTON—BOARD OF PUBLIC WORKS

SEWER DIVISION

DATE March 7/35

NO \_\_\_\_\_


The undersigned applies for the construction of a particular sewer connecting No. Colonial Beacon Oil Co Woburn Ave Street and hereby agrees to comply with the Rules and Regulations governing the construction and use of Particular Sewers, as now or at any future time established by the Board of Selectmen.

Am't. of Estimate \$ 60<sup>00</sup>

Am't. Paid \$ \_\_\_\_\_

Colonial Beacon Oil Co Owner  
R. J. Corrigan

Sketch of Service Here 10

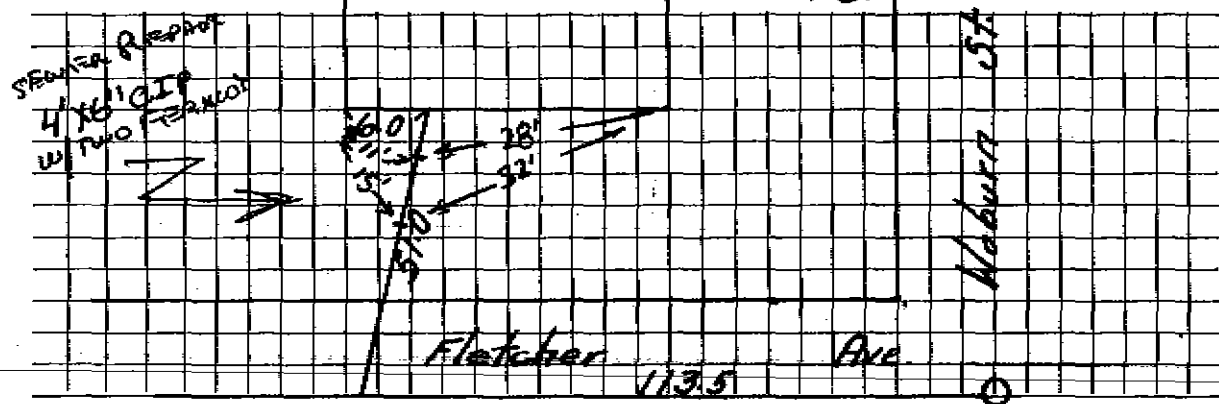

Connection made in \_\_\_\_\_ Street. Work completed \_\_\_\_\_ 19

Remarks: