

Name William Barry

Service No. 198

Address 116 Woburn Street

116 Woburn Street

Location

Kind of Pipe

Size 6"

Size of Main 8"

~~Repair~~ ~~Renewal~~ ~~New Service~~Location Camden 3-16-59

Date	Material	Amount	Total	Date	Amount
12/10/58	Labor	9 17		11-7-58	150 00
12/11/58	"	64 04		3-16-59	11 16
		73 21			161 16
	10% overhead	7 32	80 53		
	35' - 6" Transite pipe @ .70		24 50		
	1 - 6" Clay Elbow		1 88		
	5 hrs. Town Shovel @ 6.50		32 50		
	1 hr. Trucking		75		
	2 hrs. Compressor @ 3.00		6 00		
	1 hr. Trojan Loader		3 00		
	12x3 Patch		12 00		
			161 16		
	<b>Labor</b>				

**TOWN OF LEXINGTON—DEPT. OF PUBLIC WORKS**  
**SEWER DIVISION**

DATE.....

NO. ....

The undersigned applies for the construction of a particular sewer connecting No.....  
Street and hereby agrees to comply with the Rules and Regulations governing the construction and use of Particular  
Sewers, as now or at any future time established by the Board of Selectmen.


Am't of estimate \$.....

Am't Paid \$.....

..... Owner

---

**Sketch of Service Here**

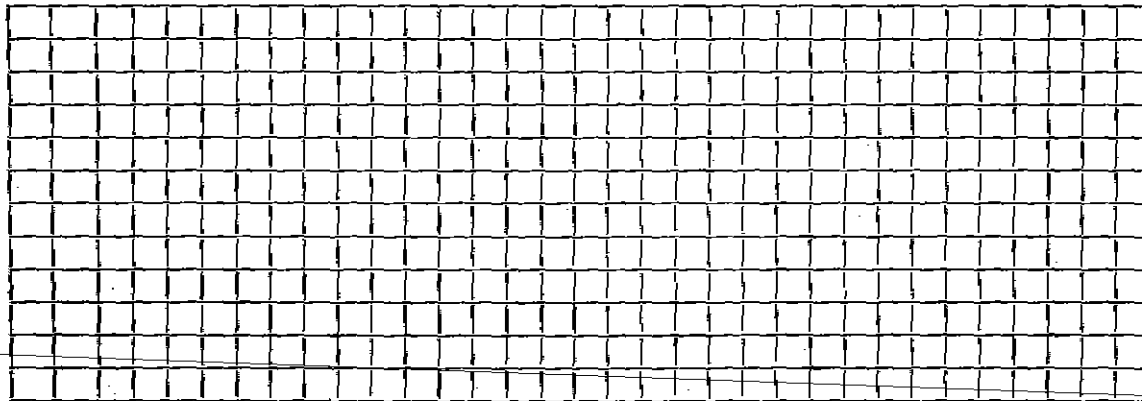

Connection made in ..... Street.

Work completed.....19..

Remarks: