

Name Ray Ferrer
 Address 116 Woburn Street

Service No. _____

116A Woburn Street

Location

Kind of Pipe


Size 6"

Size of Main 8"

Reinforced Concrete - New Service Gr-1000 #3516A

Location


Date	Material	Amount	Total	Date	Amount
9-1-50	75' 6" Transit pipe				

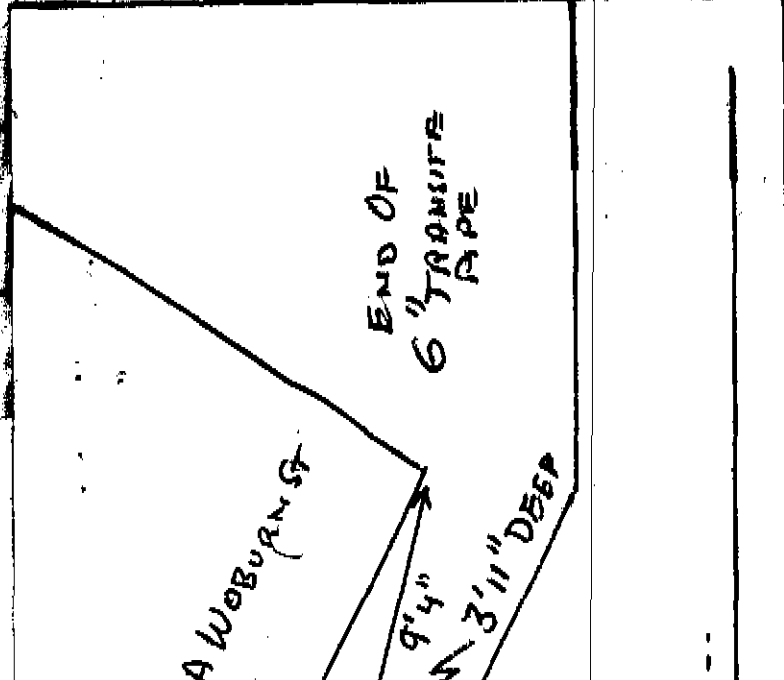

SEWER DIVISION

116A

Sketch of Service Here

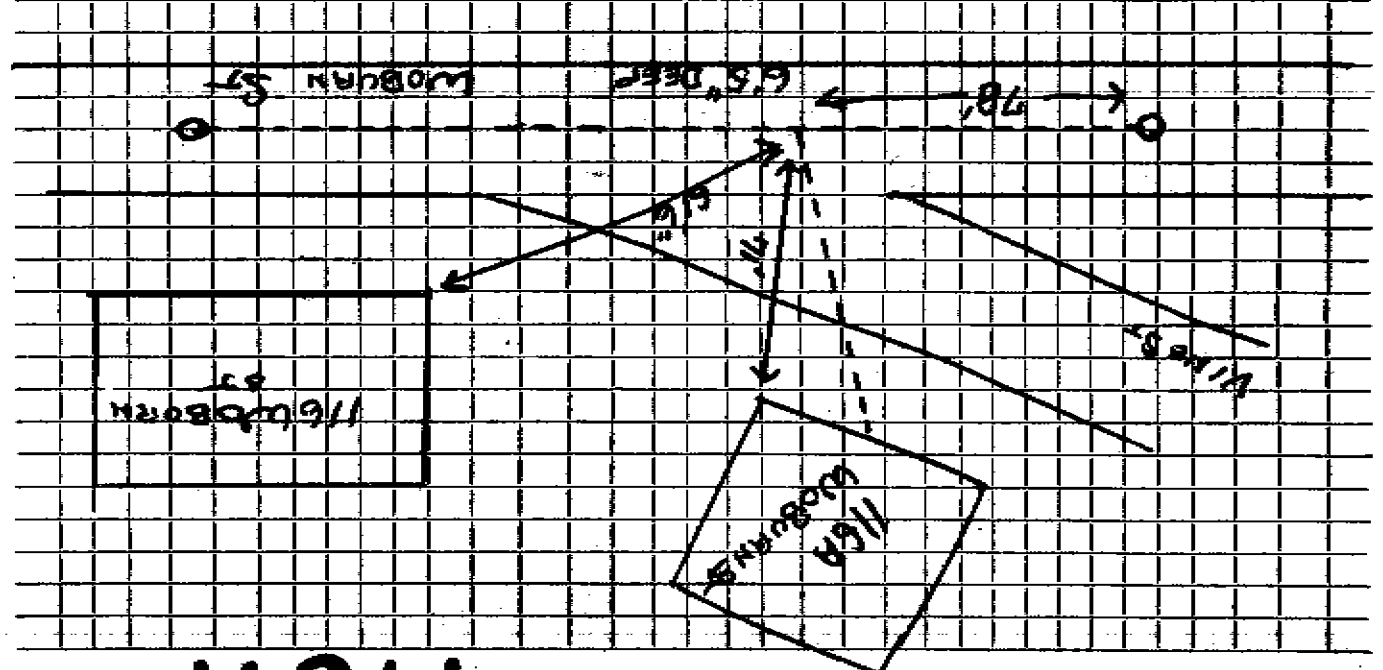

Connection made in _____ Street. Work completed _____

Remarks: _____