

Name Gerald Skinner

Service No. 61

Address 124 Woburn Street

124 Woburn Street

Location Comm. 10-8-56

Kind of Pipe

Size 6"

Size of Main 8"

~~Repair~~—New Service

Location

Date	Material	Amount	Total	Date	Amount	
6/7/56	Labor	46 02		5-28-56	Deposit	200 00
	10% Overhead	4 60	50 62	10-8-56	Refund	28 50
	56' 6" Sewer Pipe @ .455		25 48			171 50
	Joint compound		3 36	12/4/85	8'5" 6" PVC pipe	
	8 2/3 hrs. Littlefield @ 8.50		73 66		1- 6"x8" saddle	
	2 hrs. trucking @ .75		1 50		1- 6"x6" PVC clay ferro	
	1 6" Elbow		1 88		1- 6" 90° elbow PVC	
	15 x 3 Patch		15 00			
			171 50			
	Labor			3-11-89	Roots 32' to 34' out	
				11-17-85	Solids at elbow T	
				11-27-85	S.D. at Main	

TOWN OF LEXINGTON—DEPT. OF PUBLIC WORKS
SEWER DIVISION

DATE.....

NO.

The undersigned applies for the construction of a particular sewer connecting No.....
Street and hereby agrees to comply with the Rules and Regulations governing the construction and use of Particular
Sewers, as now or at any future time established by the Board of Selectmen.


Am't of estimate \$.....

Am't Paid \$.....

..... Owner

Sketch of Service Here

124

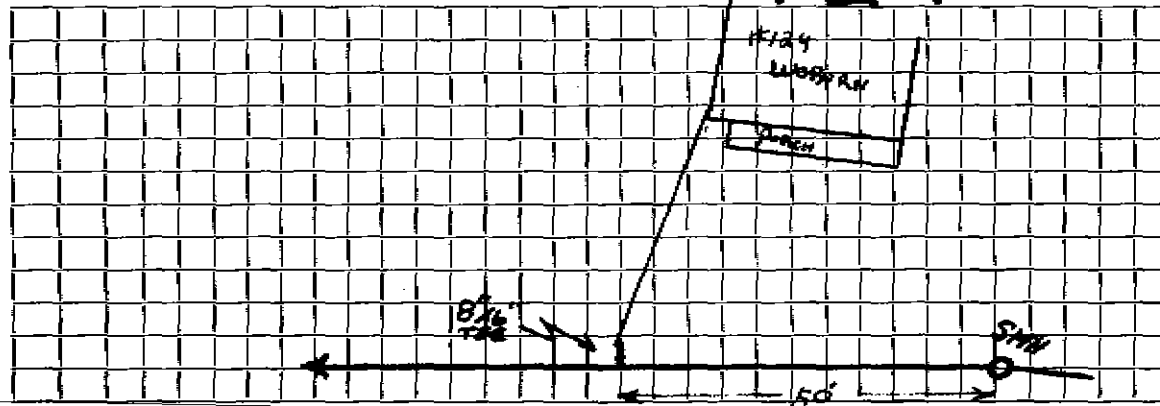

Connection made in..... Street.

Work completed.....19..

Remarks: