

Name *Anthony Filip*

Service No. 20

Address *127 Woburn Street*

127 Woburn Street

Location

Kind of Pipe

Size *6"*

Size of Main *8"*

Repair ~~Work~~ *New Service Trebino #2484*


Location

Date	Material	Amount	Total	Date	Amount
<i>5/31/1974</i>	<i>63' 6" Transite Pipe</i>				
	<i>3.5' 6" Cast Iron</i>				
				<i>5-13-74</i>	
				<i>20' 6" Transite</i>	
				<i>2' 5'x6" Nipple</i>	

DATE 8/9/74

TOWN OF LEXINGTON — BOARD OF PUBLIC WORKS
SEWER DIVISION

Sketch of Service Here 127

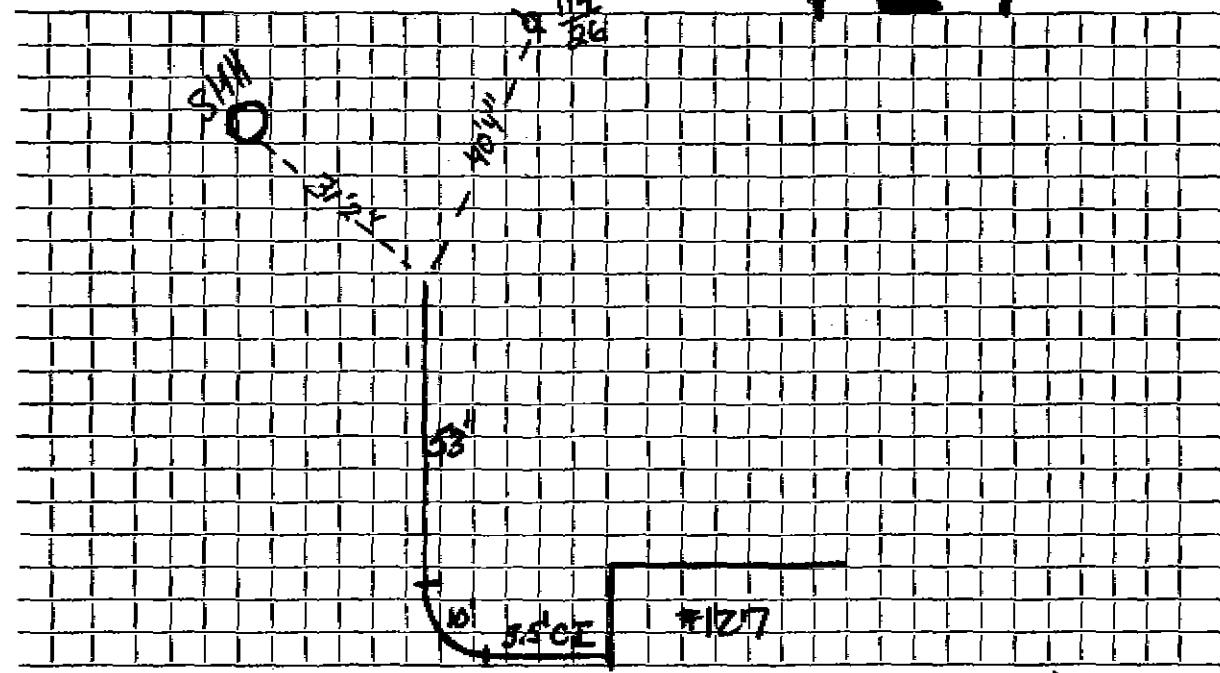

Connection made in 127 Woburn Street. Work completed 5/31/74

Remarks: