




DATE JULY 21, 1997

TOWN OF LEXINGTON — BOARD OF PUBLIC WORKS  
SEWER DIVISION

Sketch of Service Here **128**

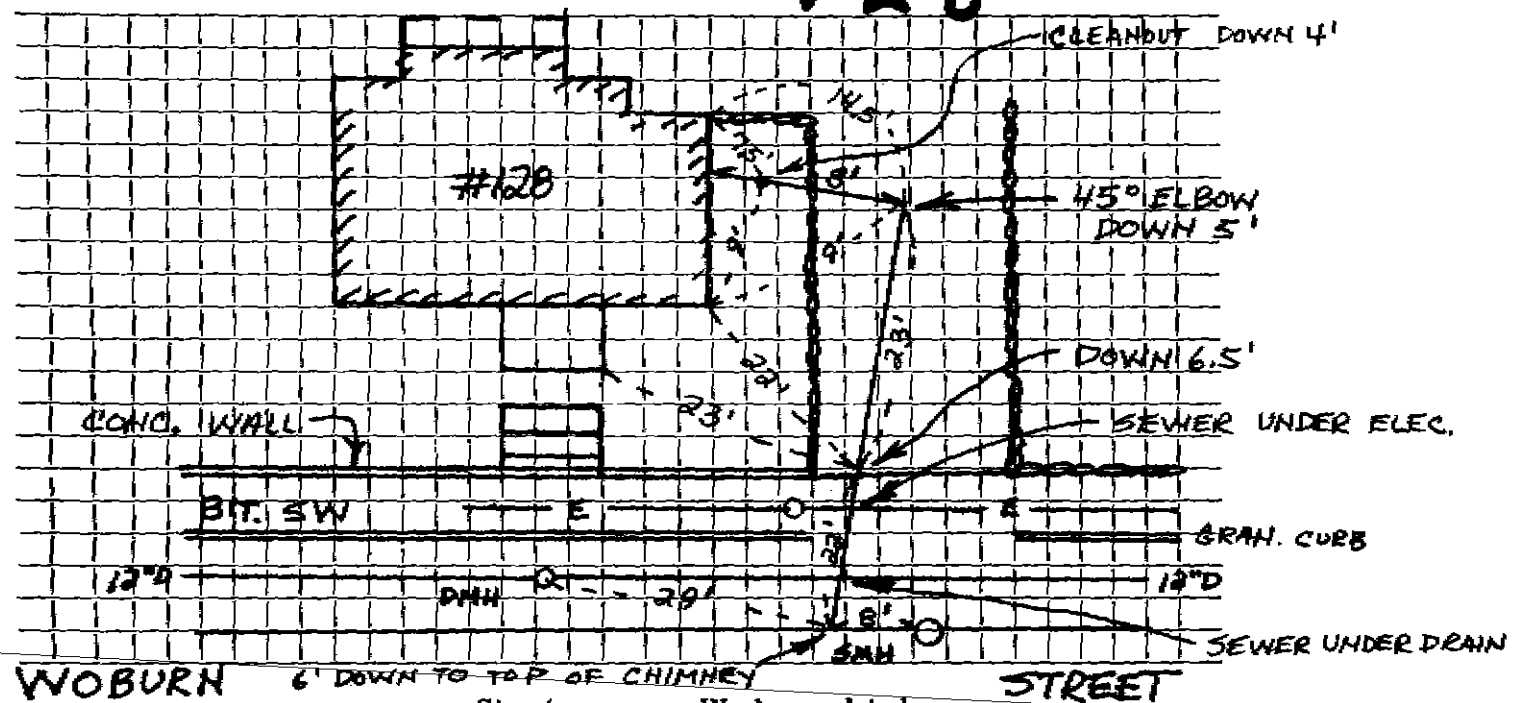

Connection made in WOBURN Street. Work completed STREET

Remarks: .....

BOOK 97-3

J.W.