

Name *Salvatore Abbadessa*

Service No. 53

Address *131 Woburn Street**131 Woburn Street*

Location

Kind of Pipe

Size *6"*Size of Main *8"*

Repair—Renewal—New Service

/Valeri #3454 W.O. #0632


Location

SEP 17 1979

Date	Material	Amount	Total	Date	Amount
7-31-79	Labor 32.53			<i>7-26-79</i>	<i>Deposit 450.00</i>
8-1-79	Labor 210.46	242.99		<i>9-21-79</i>	<i>Paid 137.56</i>
	10% O.H.	24.30	267.29		<i>587.56</i>
20'	6" Transite @1.91		38.20		
1	5' Nipple @2.33		11.65		
12	Bricks @ .12		1.44		
$\frac{1}{4}$	Bag Cement		2.48		
2	Yds. Gravel @3.00		6.00		
3 $\frac{1}{2}$	Hrs. Trucking @3.00		10.50		
2 $\frac{1}{2}$	Hrs. Compressor @5.00		12.50		
7	Hrs. Backhoe @6.50		45.50		
	Hot Top 16' X 18'		192.00		
			\$ 587.56		
8/6/79	151' 6" Transite Pipe				
	6 $\frac{1}{2}$ 4" Cast Iron Pipe				

TOWN OF LEXINGTON — BOARD OF PUBLIC WORKS
SEWER DIVISION

Sketch of Service Here **131**

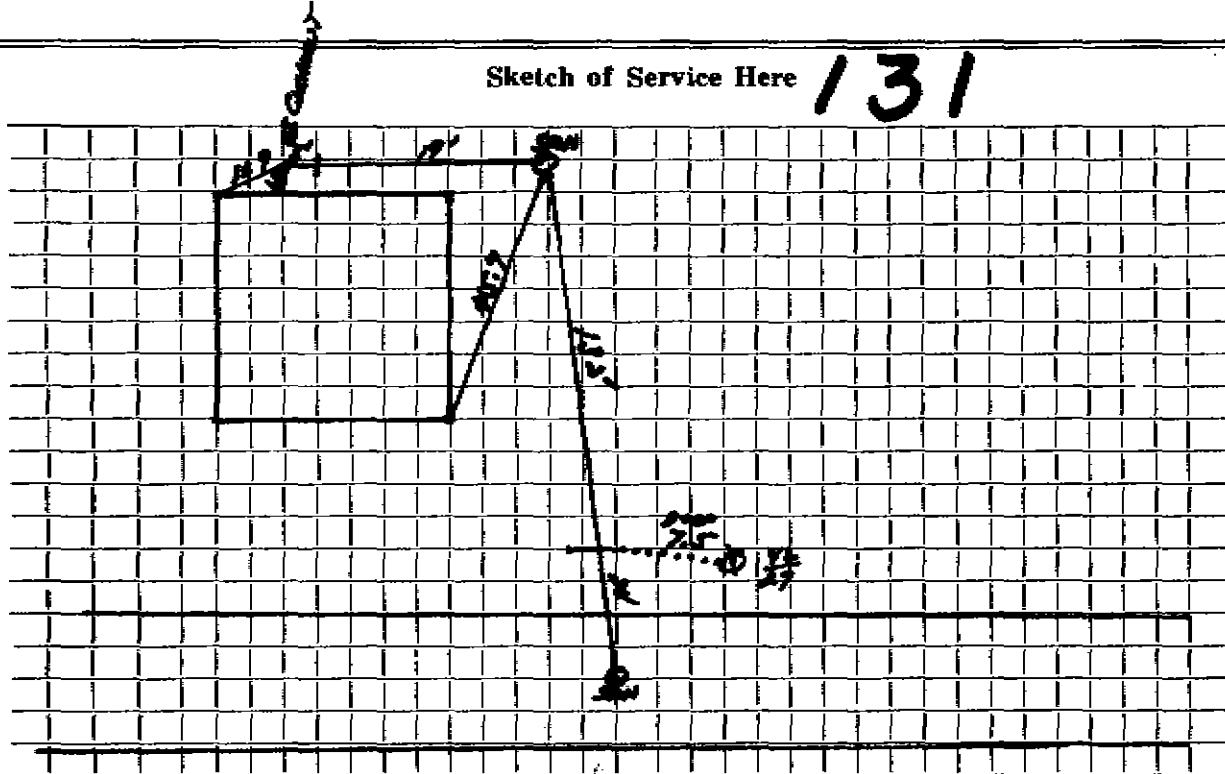

Connection made in _____ Street. Work completed _____

Remarks: _____

