

Name Christen Bentsen

Service No.

123

Address 132 Woburn St.

Lexington 73, Mass. **132 Woburn** Location **ST.**

Kind of Pipe

Size **6"**Size of Main **8"**~~Repair~~ ~~Renewal~~ - New Service COM. 10-15-51

Location

Date	Material	Amount	Total	Date	Amount
9/14/51	Labor	25 65		9-14-51	Deposited 125 00
9/15/51	"	21 94	47 59	10-15-51	Refunded 17 82
	10% overhead		4 76		" 9 credited to W.H.C. # 215
	38' - 6" sewer pipe @ .342		13 00		
	1 - 6" elbow		1 88		
	joint compound		2 28		
	5 hrs. Littlefield shovel		35 00		
	2 hrs. trucking		1 50		
			106 01		
	Labor				

TOWN OF LEXINGTON—DEPT. OF PUBLIC WORKS
SEWER DIVISION

DATE

NO.


The undersigned applies for the construction of a particular sewer connecting No.
Street and hereby agrees to comply with the Rules and Regulations governing the construction and use of Particular
Sewers, as now or at any future time established by the Board of Selectmen.

Am't of estimate \$.

Am't Paid \$.

..... Owner

Sketch of Service Here

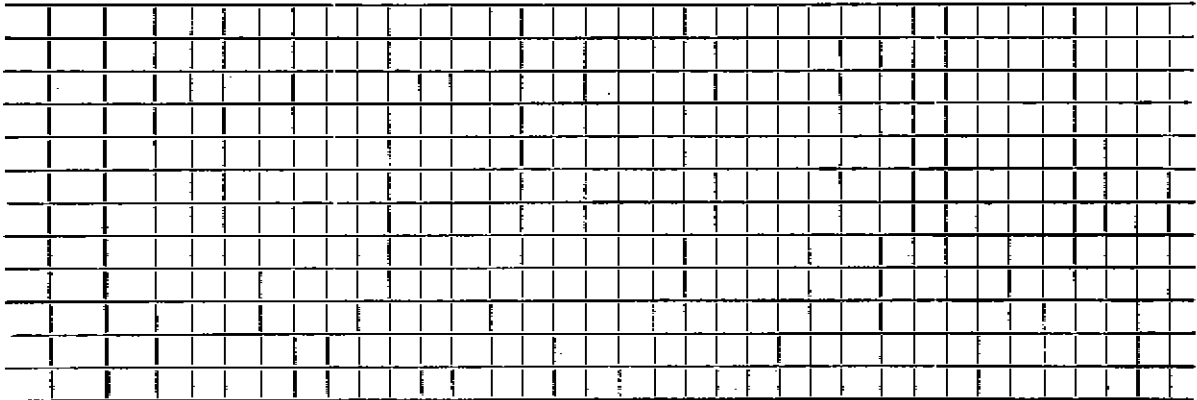

Connection made in Street.

Work completed 19..

Remarks: