

Name **Wallace Cupp**

Service No. **62**

Address **141 Woburn Street**

141 Woburn Street

Location

Kind of Pipe

Size **6"**

Size of Main **8"**

~~REPLACEMENT~~ — New Service

COM. 7-19-54

Location

Date	Material	Amount	Total	Date		Amount
5/20/54	Labor	29 30		4-21-54	Deposited	250 00
5/24/54	"	62 07	91 37	7-20-54	Refunded	(29 28)
	10% overhead		9 14			220 72
	86' - 6" sewer pipe @ .3087		26 55			
	joint compound		5 16			
	10 hrs. Littlefield shovel @ 7.50		75 00			
	2 hrs. trucking @ .75		1 50			
	patching 12 x 3		12 00			
			<u>220 72</u>			
	Labor			8-21-74	S ag in line	
				8-26-66	SAG PIPE	
				7/27/67	DeBRIS	
				7/17/71	sludge	

TOWN OF LEXINGTON—DEPT. OF PUBLIC WORKS
SEWER DIVISION

DATE.....

NO.


The undersigned applies for the construction of a particular sewer connecting No.....
Street and hereby agrees to comply with the Rules and Regulations governing the construction and use of Particular
Sewers, as now or at any future time established by the Board of Selectmen.

Am't of estimate \$.....

Am't Paid \$.....

..... Owner

Sketch of Service Here

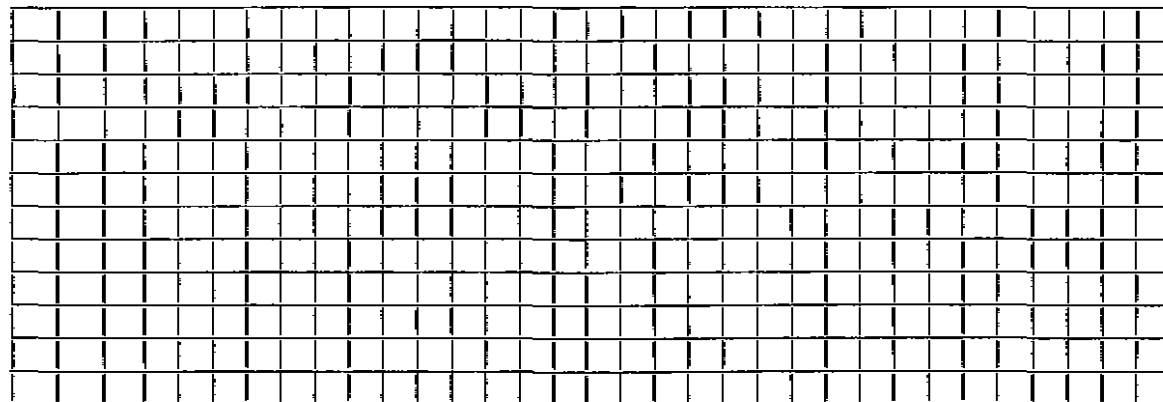

Connection made in

Street.

Work completed.....19..

Remarks: