

Name James Doherty

Service No. 42

Address 147 Woburn Street

Lexington **147 Woburn ST.** Location 147 Woburn Street

Kind of Pipe

Size 6"

Size of Main 8"

~~Repair to Existing~~ - New Service

Com. 11-6-50

Location

Date		Material	Amount		Total	Date		Amount		
June 26	'50	Labor	41	83		June 22	'50	Deposited	150	00
June 27	'50	Labor	32	66		Nov. 16	'50	Refunded	12	20
		10% Overhead	77	45	81	94			137	80
		54' - 6" Sewer Pipe @ 28¢			15	12				
		Joint Compound			3	24				
		3 hrs. Littlefield Shovel			21	00				
		2 hrs. Trucking			1	50				
		Patching 15 x 3			15	00				
					137	80				
		Labor								

TOWN OF LEXINGTON—DEPT. OF PUBLIC WORKS
SEWER DIVISION

DATE

NO.


The undersigned applies for the construction of a particular sewer connecting No.
Street and hereby agrees to comply with the Rules and Regulations governing the construction and use of Particular
Sewers, as now or at any future time established by the Board of Selectmen.

Am't of estimate \$

Am't Paid \$

..... Owner

Sketch of Service Here

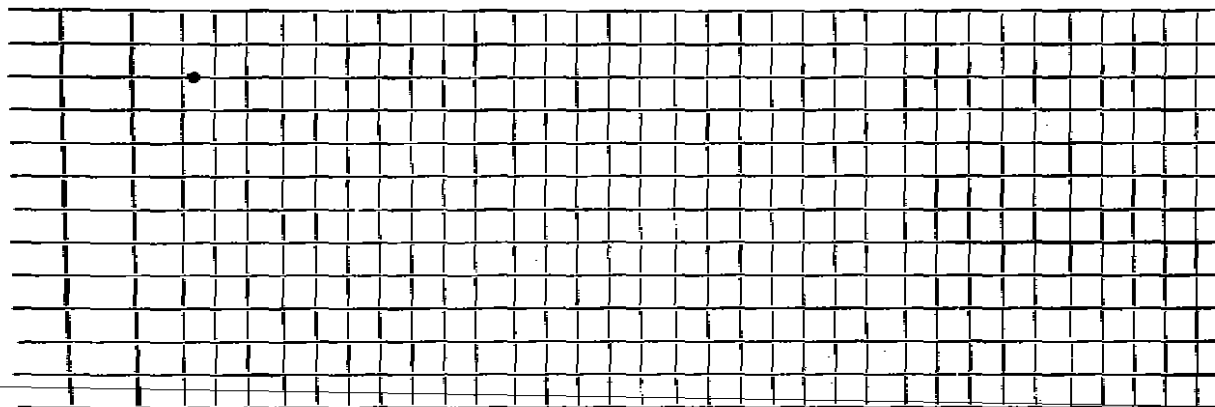

Connection made in Street.

Work completed 19..

Remarks: