



TOWN OF LEXINGTON — BOARD OF PUBLIC WORKS


SEWER DIVISION

DATE

152

Sketch of Service Here

152 WILSON ST

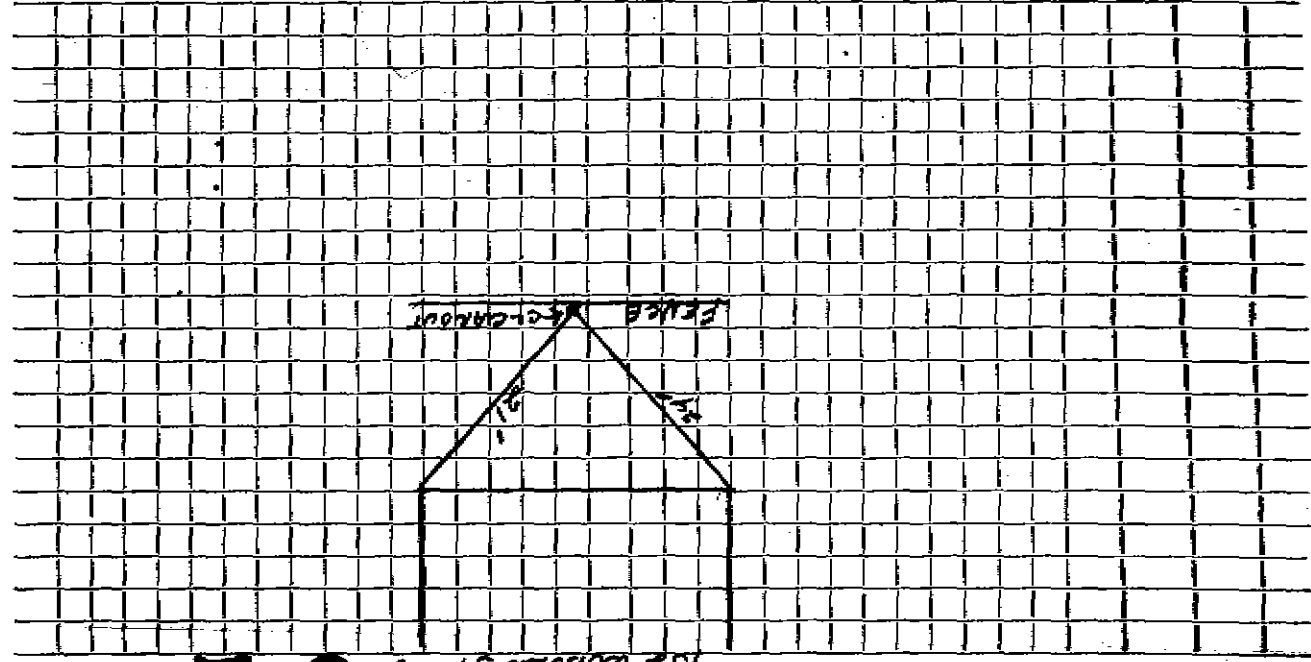

Connection made in Street. Work completed

Remarks: