

Name Rose Hanna

Service No. 113

Address 170 Mobern Street

170 Mobern Street

Location

Kind of Pipe

Size 6"

Size of Main 8"

Location

Location

Com. 11-13-61


Date	Material	Amount	Total	Date	Amount
10/485/61	Labor	60.01		8-31-61	Deposit
	10% O.H.	6.00	66.01	1-4-62	Paid
56'	6" Transit pipe @.78		43.68	2-8-62	"
18'	6" Cast iron Water pipe @2.09		37.62	4-6-62	"
3	hrs. Town Shovel @6.50		19.50	5-9-62	"
2	hrs. Trucking @3.00		6.00	m %c	25 -
			172.81	m %c	25 -
	Sewer Main		462.06	ex %c	25 -
	(card attached)		634.87	m %c	25 -
				m %c	25 -
				m %c	25 -
				m %c	25 -
				Paid	25 00
					634.87
				Bill sent	334.87

DATE _____

TOWN OF LEXINGTON — BOARD OF PUBLIC WORKS

SEWER DIVISION

Sketch of Service Here

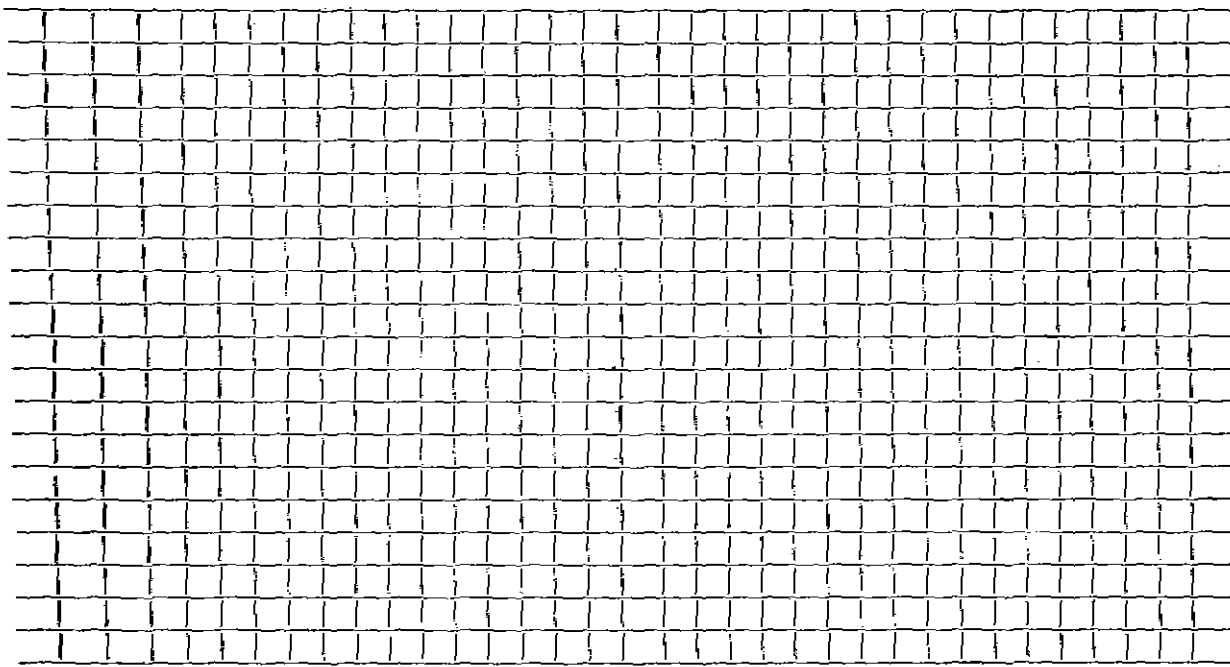

Connection made in Street. Work completed

Remarks:
.....
.....

Name

Service No. 113

Address Woburn Street Sewer Main (170 Woburn St.)

Location

Kind of Pipe

Size

Size of Main

~~Repair/Alteration~~—New Service

Location


Date	Material	Amount	Total	Date	Amount
10/18/56	Labor 96.83				
	10% O.H. 9.68	106.51			
	Labor 57.98				
	10% O.H. 5.80	63.78	170.29		
	122' 6" Transite pipe @.78		95.16		
	18 1/2 ton Gravel @.85		15.51		
	5 bag Cement @1.50		7.50		
	800 Sewer Brick @4.20 per 100		33.60		
	1 Manhole Cover & Frame		35.00		
	2 ton Brick Sand @1.00		2.00		
	10 ton C.I. Top @5.00 ton		50.00		
	4 hrs. Town Shovel @6.50		26.00		
	5 hrs. Trucking @3.00		15.00		
	2 hrs. Trojan Loader @3.00		6.00		
	2 hrs. Compressor @3.00		6.00		
			462.06		

DATE

SEWER DIVISION

TOWN OF LEXINGTON — BOARD OF PUBLIC WORKS

Sketch of Service Here

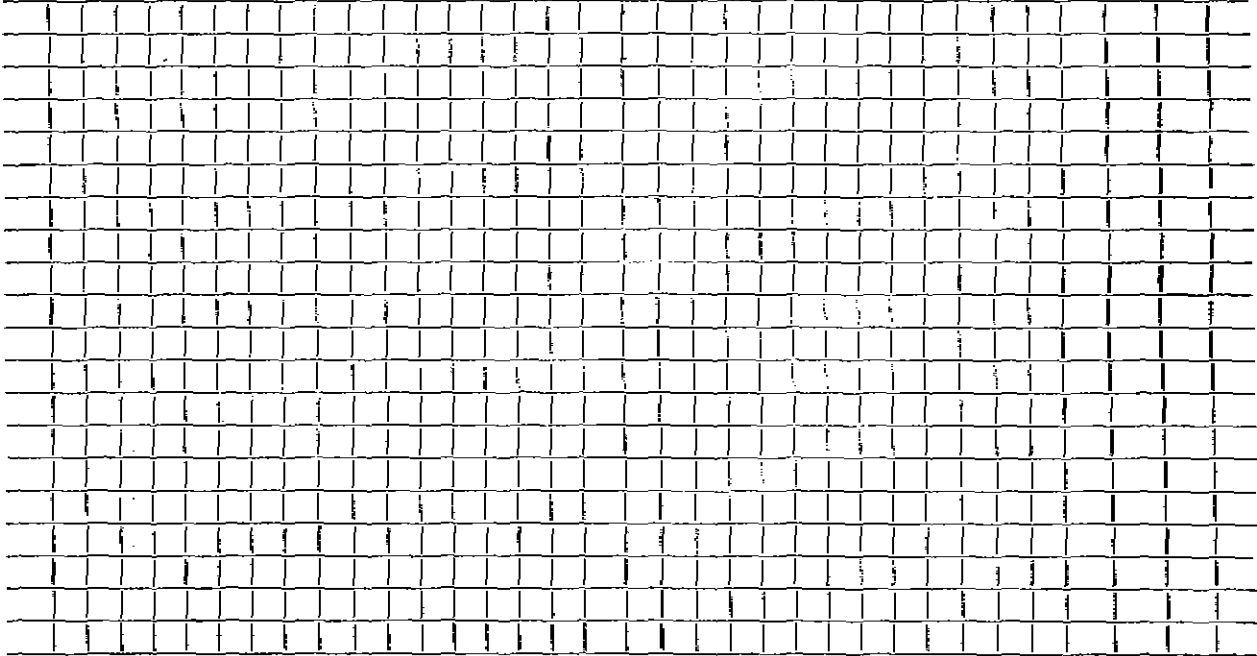

Connection made in Street. Work completed

Remarks: