




SEWER DIVISION

Sketch of Service Here  
**171**

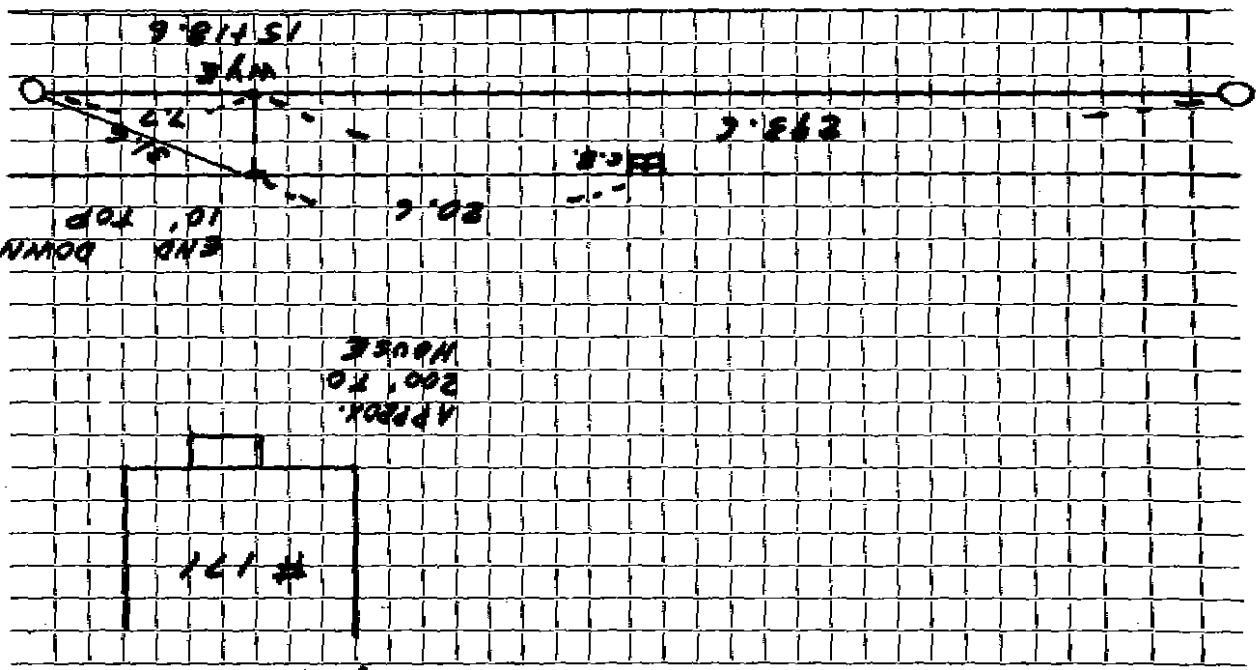

Connection made in \_\_\_\_\_ Street. \_\_\_\_\_ Work completed \_\_\_\_\_  
 Remarks: \_\_\_\_\_