

Name

Service No.

Address 180 WOBURN ST. (VACANT LOT)

180 Woburn Street

Location

Kind of Pipe

Size 6" A.C.

Size of Main 8"

Repair—Renewal—New Service

Location

Date	Material	Amount	Total	Date	Amount
8-8-73	24' A.C. @ \$9.00	216.00			


DATE _____

TOWN OF LEXINGTON — BOARD OF PUBLIC WORKS

SEWER DIVISION

Sketch of Service Here

180

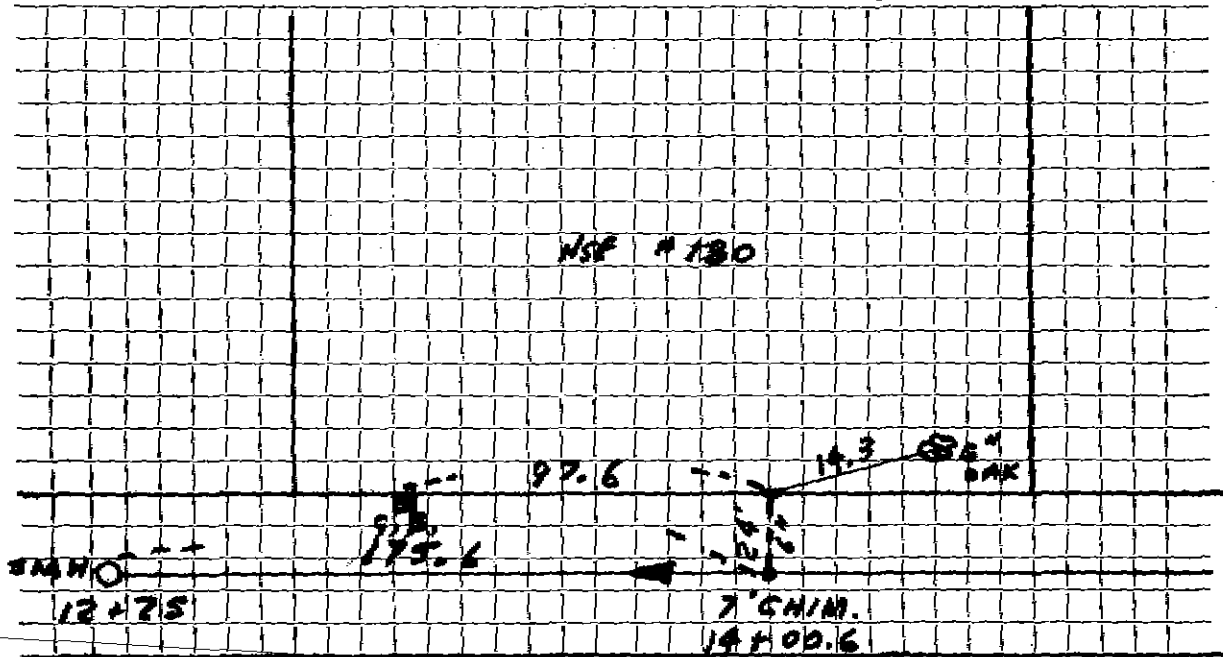

Connection made in Street. Work completed

Remarks:

.....

.....