




TOWN OF LEXINGTON — BOARD OF PUBLIC WORKS

SEWER DIVISION

Sketch of Service Here

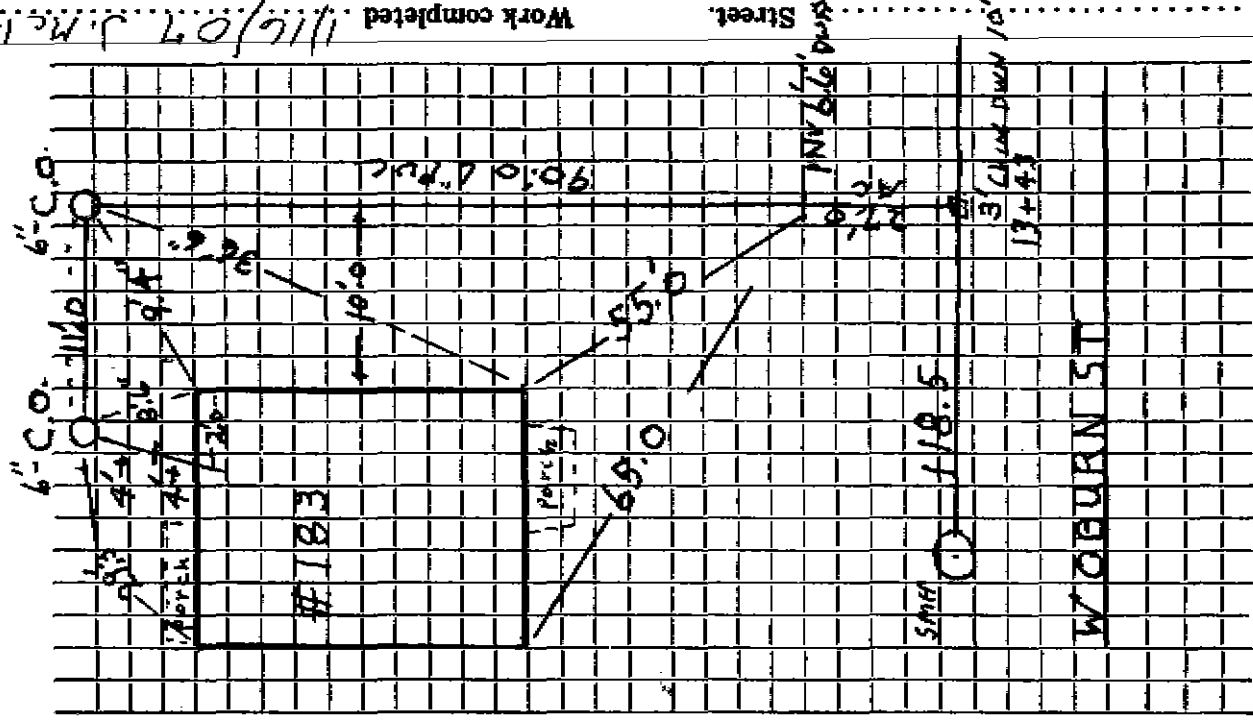

Connection made in

Street.

Work completed

11/6/07 J. McLaughlin

Remarks: