


DATE Aug 1973

TOWN OF LEXINGTON — BOARD OF PUBLIC WORKS
SEWER DIVISION

Sketch of Service Here

191

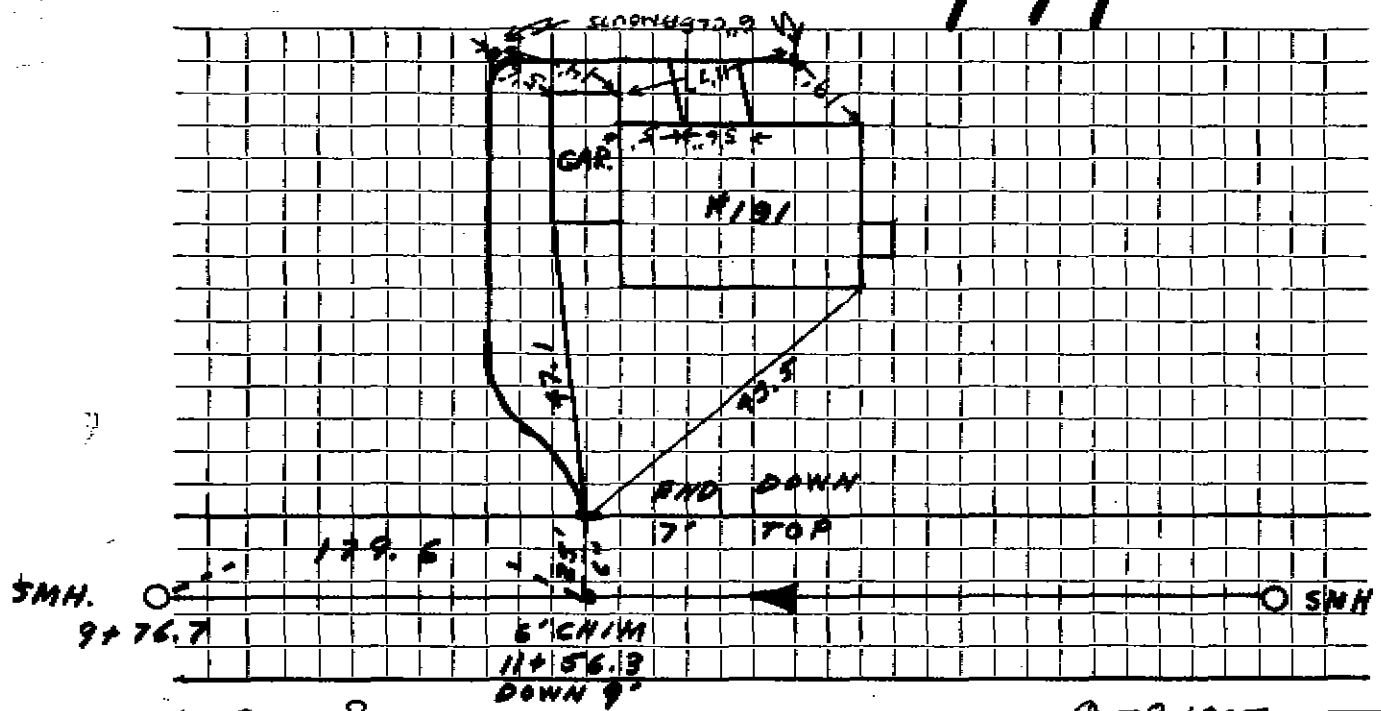

Connection made in Woburn St. Street. Work completed Oct 9, 1905

Remarks: 4" C.I.P. UNDER BASEMENT FLOOR. STILL CONNECTED TO SEP. TIGHTEN. - TAMES. PAR. OF
ALL BASEMENT FACILITIES - TANK APPROX. 36' OUT FROM HOUSE