

Name

Service No.

Address 192 WOBURN ST.

192 Woburn Street

Location

Kind of Pipe

Size 6" A.C.

Size of Main 8"

Repair—Renewal—New Service

Location



Date	Material	Amount	Total	Date	Amount
8-8-73	23' 6" A.C. @ 9.00	\$207.00			
	J McLaughlin				
	INST ST. TO HOUSE				

DATE \_\_\_\_\_

# TOWN OF LEXINGTON — BOARD OF PUBLIC WORKS SEWER DIVISION

Sketch of Service Here

# 192

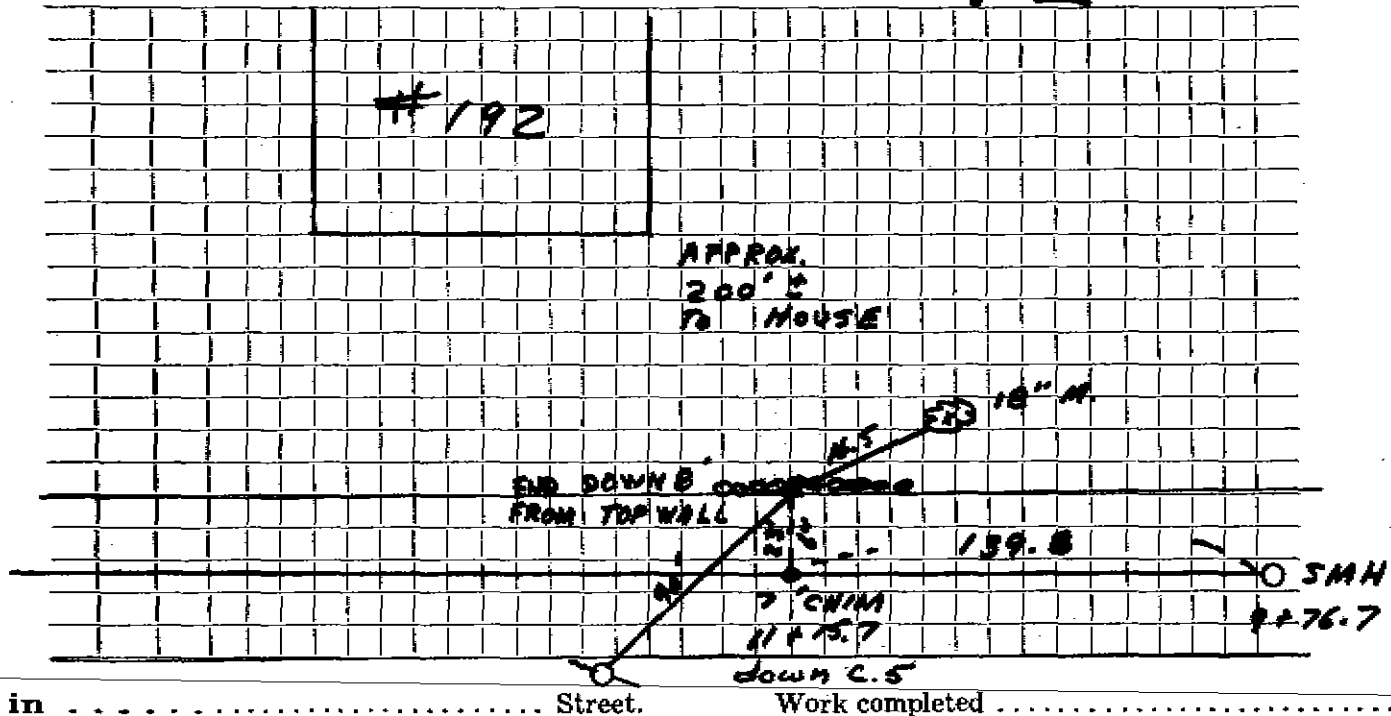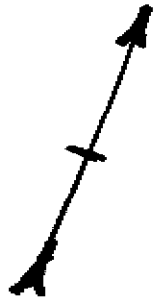

Connection made in ..... Street. Work completed .....

Remarks: .....

.....

.....