

Service No.

Name 197 Warren St
Address 197 Warren Street

Location

Kind of Pipe A. C. Size 6 "

Repair—Renewal—New Service


Size of Main 6 "

Location

Date	Material	Amount	Total	Date	Amount
AUG 1976	1 - TEE'	N.C.			

DATE AUG 1973

TOWN OF LEXINGTON — BOARD OF PUBLIC WORKS
SEWER DIVISION

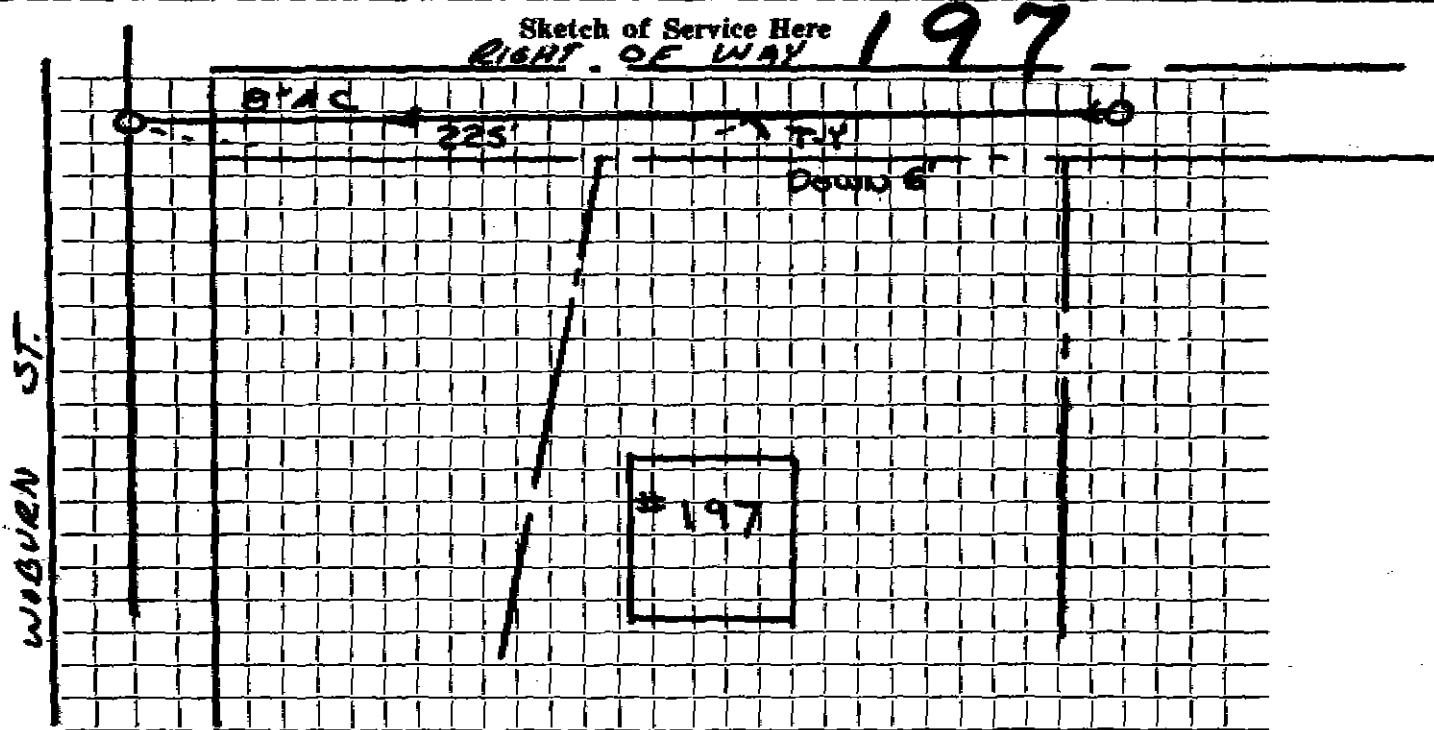

RIGHT OF WAY OFF

Connection made in WOBURN ST. Street.

Work completed

Remarks: