


TOWN OF LEXINGTON — BOARD OF PUBLIC WORKS

SEWER DIVISION

DATE _____

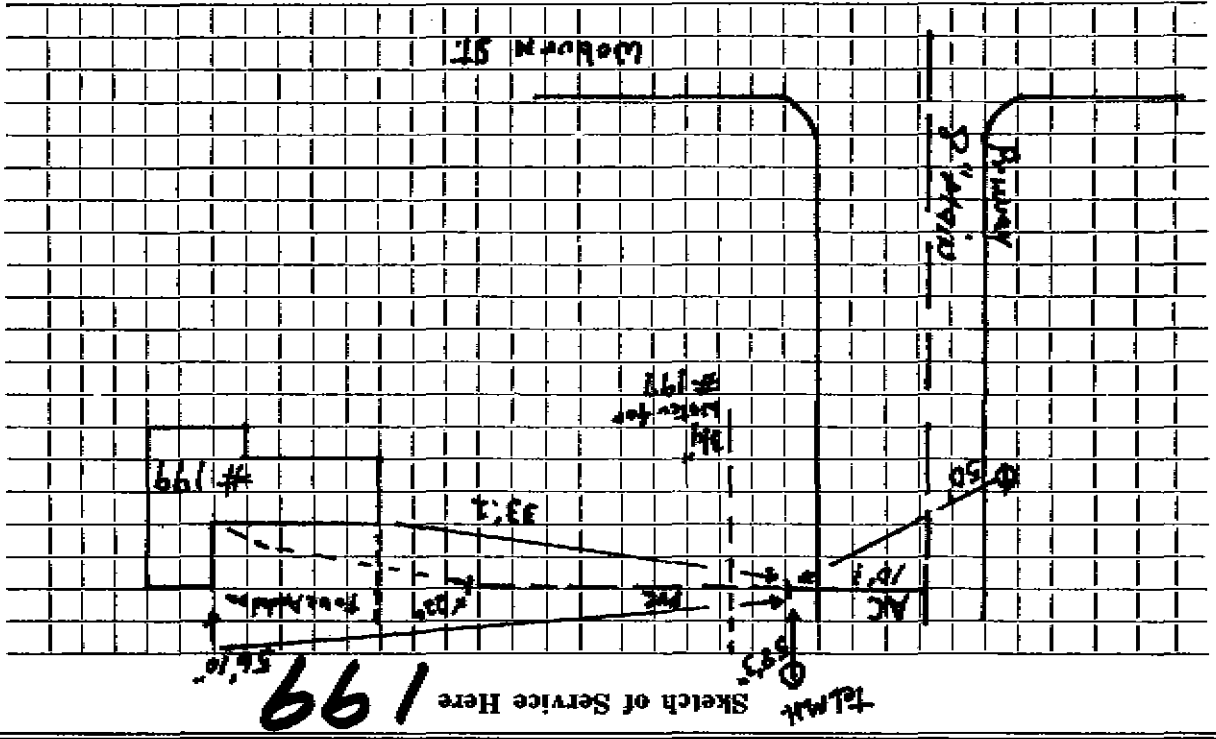

Sketch of Service Here
 199
 5.6' 10"

Connection made in _____ Street.
 Work completed _____
 Remarks: water service 3' from AC to PUC. Adpt. 2.5' pipe 28' down