

Name

Service No.

Address 201 Woburn St (vac lot)

201 Woburn Street Location

Kind of Pipe A.C.

Size 6"

Size of Main 8"


Repair—Renewal—New Service

Location

Date	Material	Amount	Total	Date	Amount
AUG 76	5'-6" A.C. @ \$	45 00			

DATE Aug 1973

TOWN OF LEXINGTON — BOARD OF PUBLIC WORKS  
SEWER DIVISION

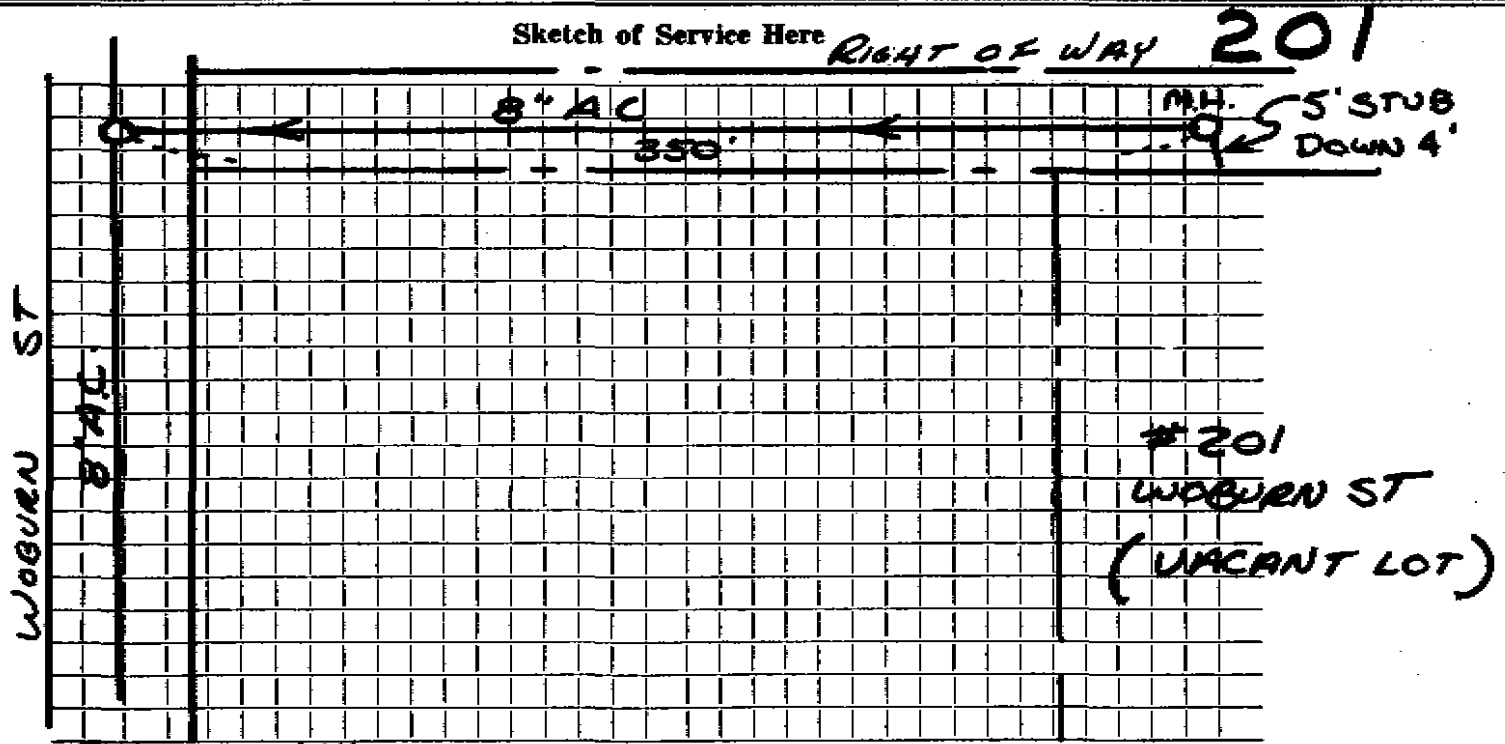

Connection made in OFF WOBURN ST Street. Work completed .....

Remarks: .....

.....

.....