

Name

Service No.

Address *VACANT LOT BETWEEN HSE #229 & HSE #210 WOBURN ST.*

Location

Kind of Pipe

Size *6" A.C.*

Size of Main *8"*

Repair—Renewal—New Service


Location

Date	Material	Amount	Total	Date	Amount
<i>5-24-73</i>	<i>29' 6" A.C. @ \$9.00</i>	<i>\$ 261.00</i>			

DATE _____

TOWN OF LEXINGTON — BOARD OF PUBLIC WORKS
SEWER DIVISION

Sketch of Service Here

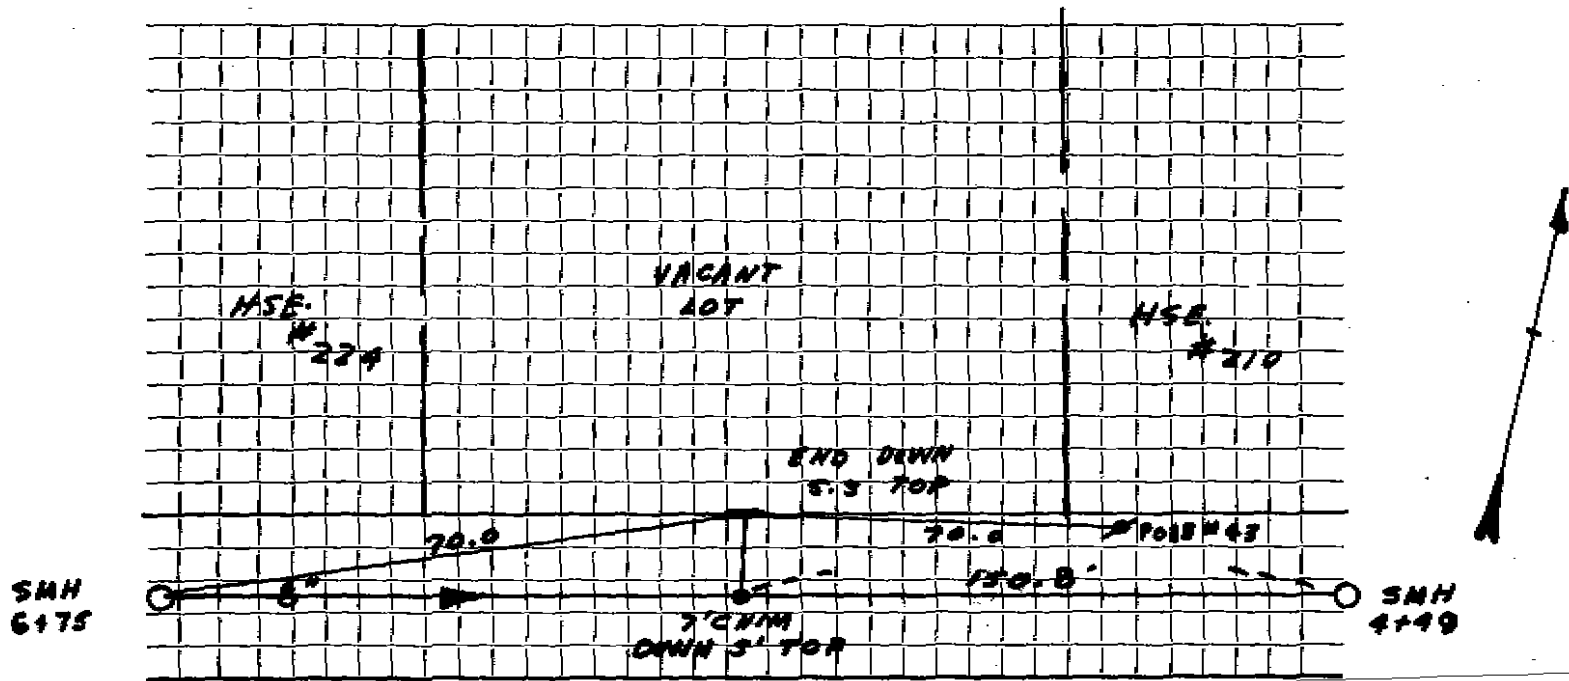

Connection made in Street. Work completed

Remarks:

.....

.....

Name Robert MacEwen

Service No. 195

Address 210 WOBURN ST.

210 Woburn Street

Location

Kind of Pipe

Size 6" AC

Size of Main 8"

Repair—Renewal—New Service ✓ Valeri Const. #2385


Location APR 8 1974

Date	Material	Amount	Total	Date	Amount	
5-25-73	26' 6" A.C @ \$9.00	\$234.00		12-5-73	Deposit	334.00
12-17-73	36' - 6" ACP					
	10' - 4" CI					

DATE _____

TOWN OF LEXINGTON — BOARD OF PUBLIC WORKS
SEWER DIVISION

Sketch of Service Here **210**

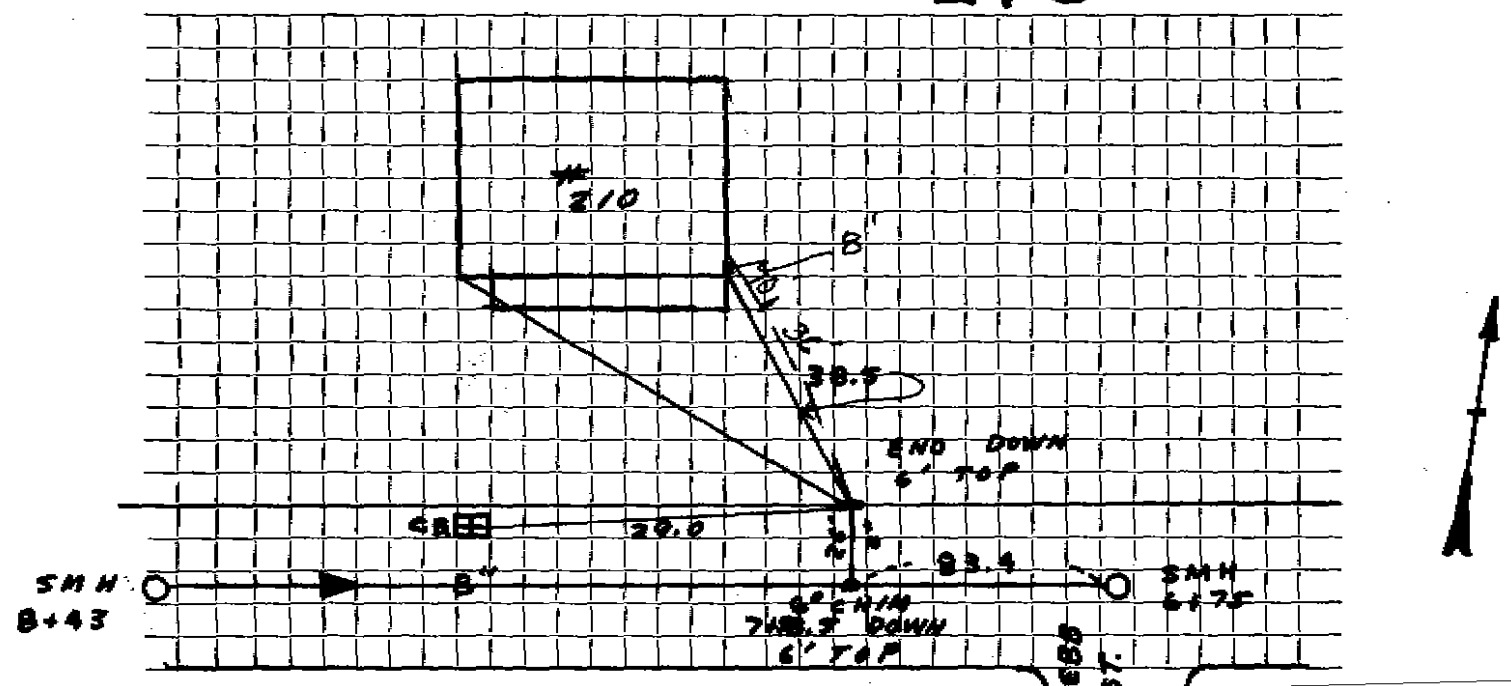

Connection made in Street. Work completed
3688 ST.

Remarks:
.....
.....