


DATE _____

TOWN OF LEXINGTON — BOARD OF PUBLIC WORKS
SEWER DIVISION

Sketch of Service Here

211

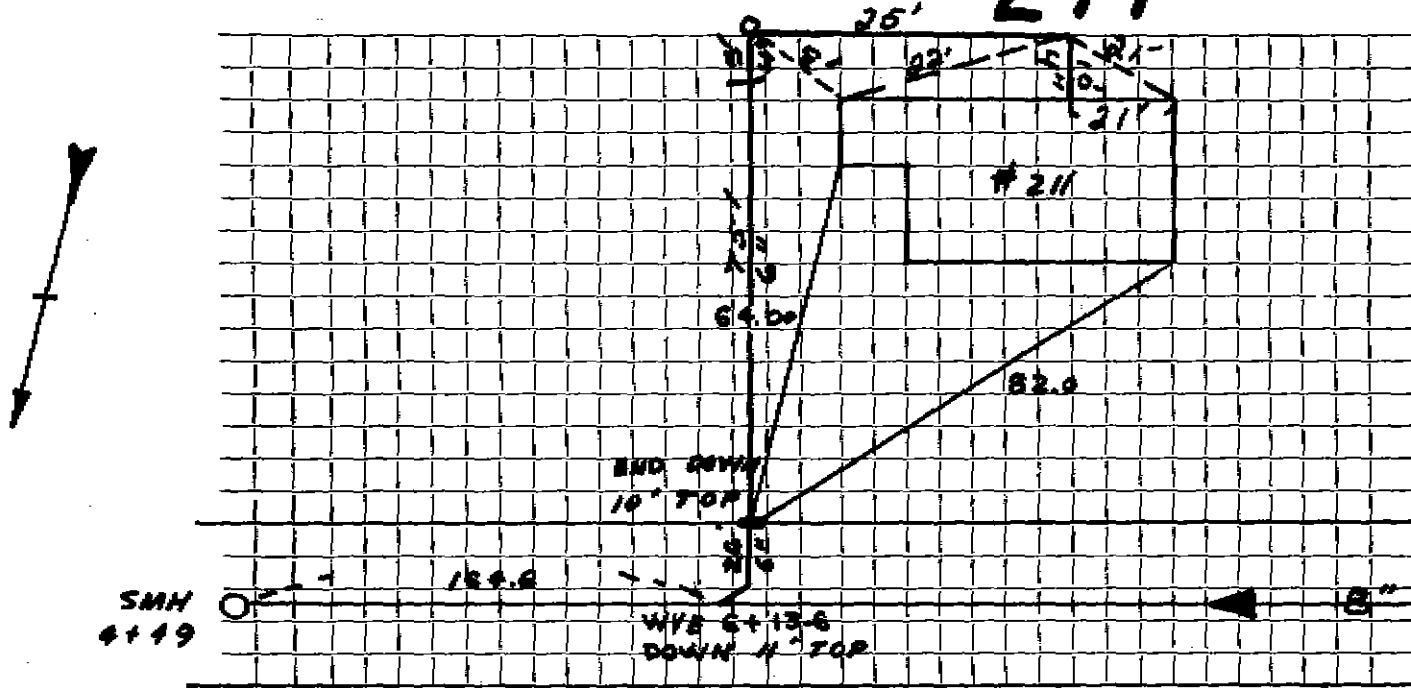

Connection made in 211 Woburn St. Street.

Work completed 12/10/75

Remarks:

.....

.....