

Name James P. Leavitt

Service No. 178

Address 221 WOBURN ST.

221 Woburn Street

Location

Kind of Pipe

Size 6" A.C.

Size of Main 8"

Repair—Renewal—New Service Valeri Const. # 2436


Location APR 8 1974

Date	Material	Amount	Total	Date	Amount	
5-23-73	26' 6" ACP @ 9.00	234.00		11-15-73	Deposit	334.00
12-13-73	27' - 6" ACP					
	10' - 4" CI					

DATE _____

TOWN OF LEXINGTON — BOARD OF PUBLIC WORKS
SEWER DIVISION

Sketch of Service Here **221**

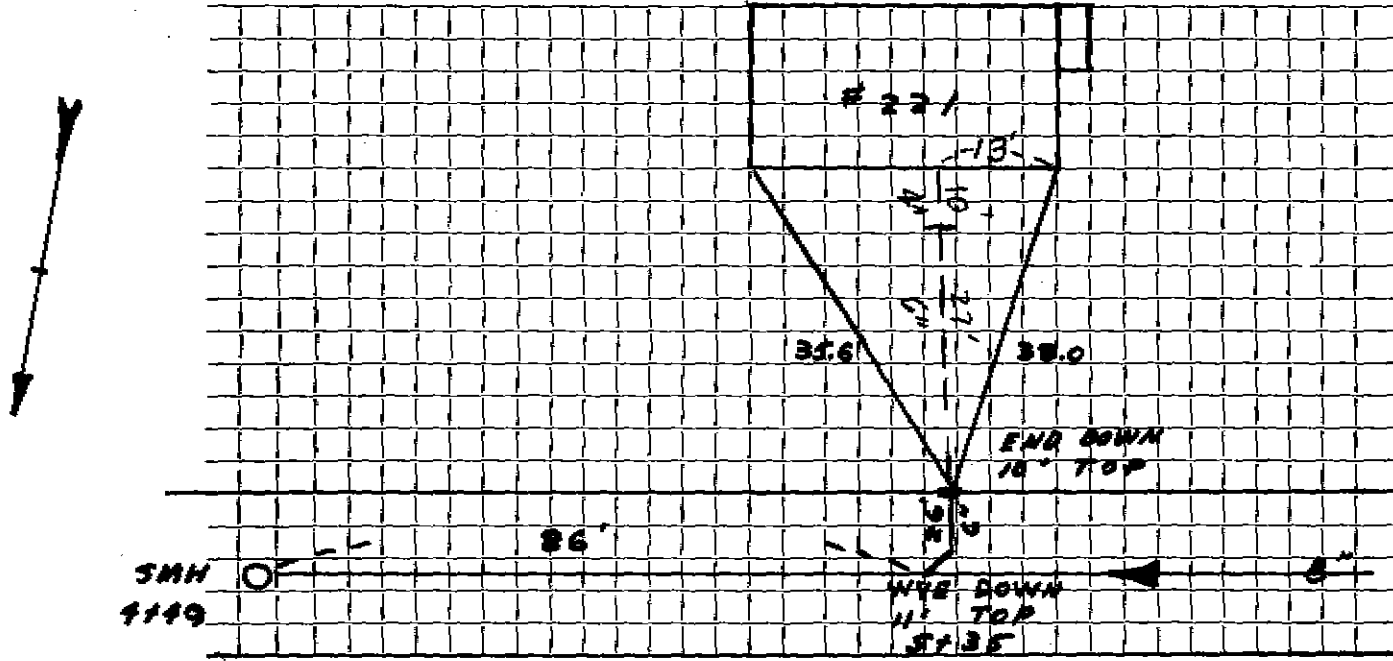

Connection made in _____ Street. Work completed _____

Remarks: _____

