

Name Nish Semonian

Service No. 42 (175)

Address 224 WOBURN ST.
224 Woburn Street

Location

Kind of Pipe Size 6" A.C.

Size of Main 8"

Repair—Renewal—New Service Valeri #2648

Location AUG 16 1976

Date	Material	Amount	Total	Date	Amount	
5-29-73	26' 6" A.C. @ \$9.00	\$234.00		5-19-75	Deposit	234.00
5/28/75	140' 6" Transite pipe					
	10' 4" Cast Iron Pipe					


F.A.N. 18501

DATE _____

TOWN OF LEXINGTON — BOARD OF PUBLIC WORKS

SEWER DIVISION

Sketch of Service Here **224**

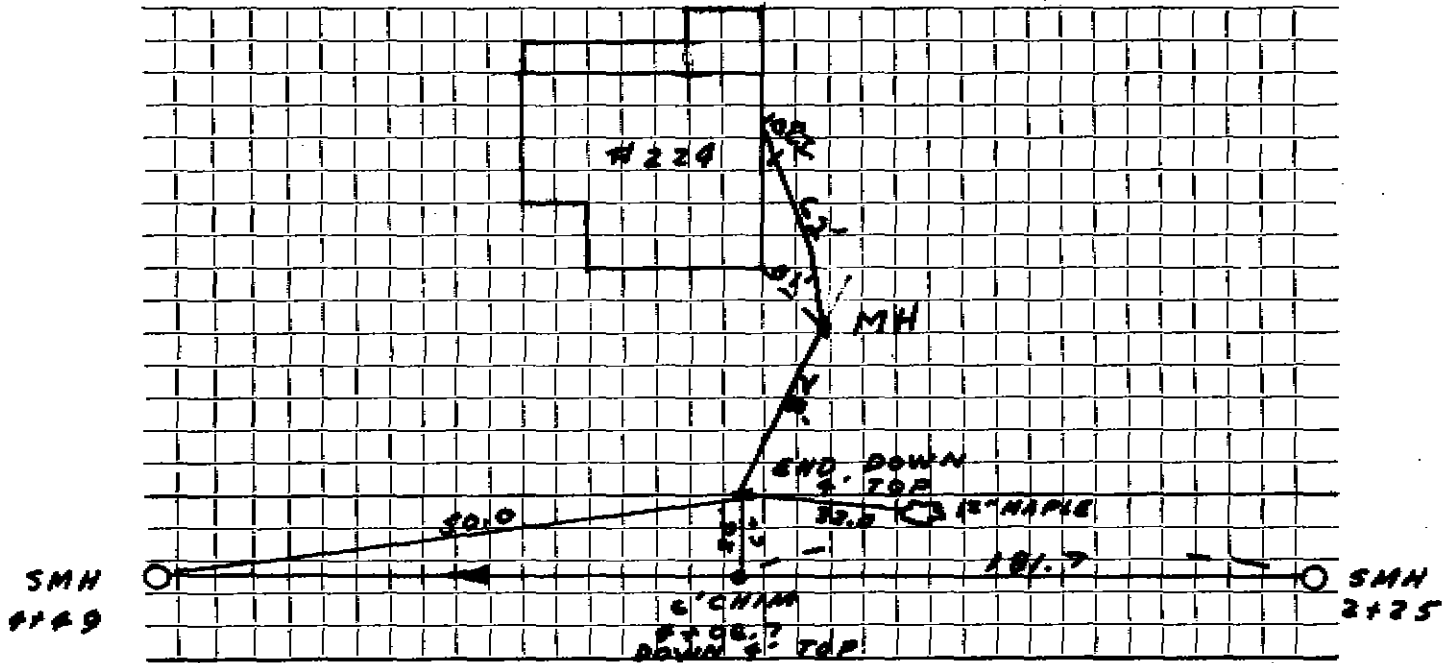

Connection made in 224 Woburn St. Street. Work completed 5/28/75

Remarks:

.....

.....