


DATE _____

TOWN OF LEXINGTON — BOARD OF PUBLIC WORKS

SEWER DIVISION

Sketch of Service Here **227**

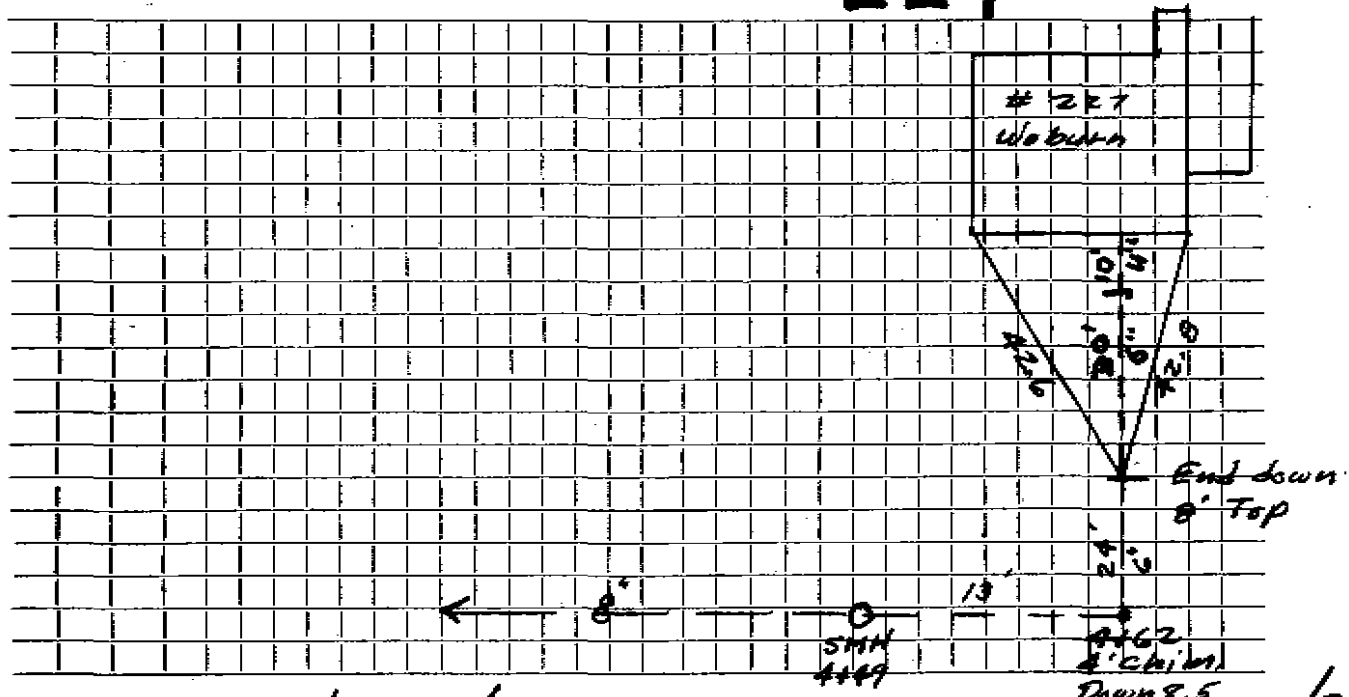

Connection made in 227 Woburn St. Street. Work completed 4/3/75

Remarks: