


DATE 11-12-97

TOWN OF LEXINGTON — BOARD OF PUBLIC WORKS SEWER DIVISION

Sketch of Service Here

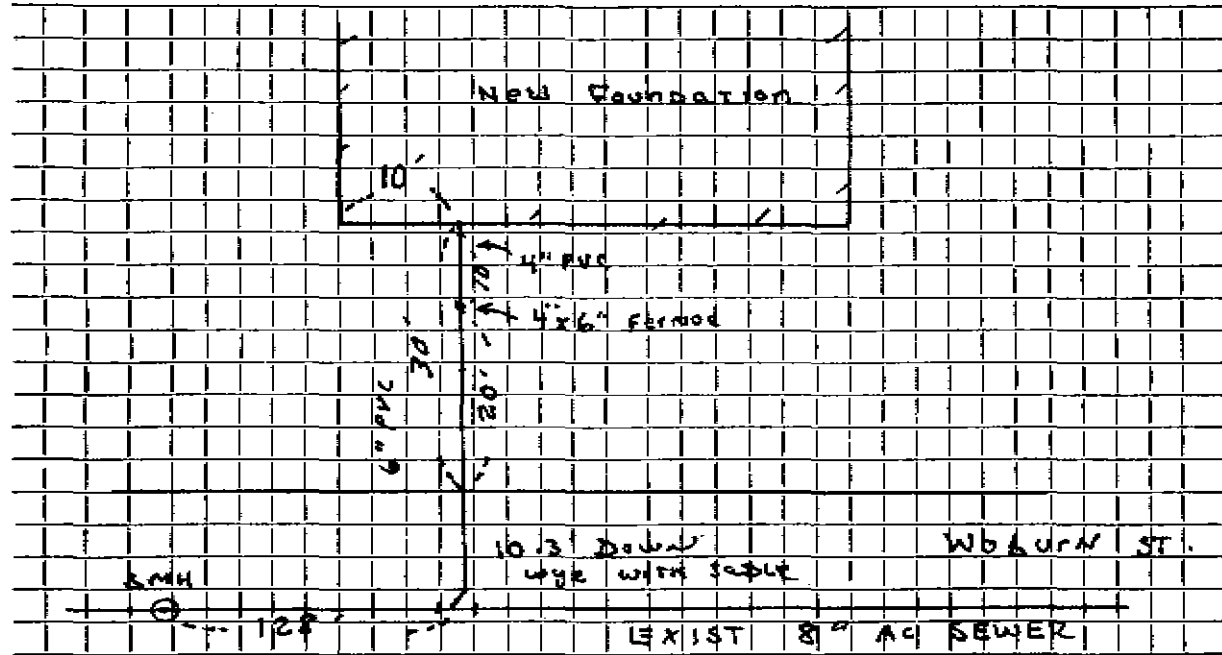

TJW

Connection made in Woburn Street. Work completed


Remarks:
.....
.....

DATE _____

TOWN OF LEXINGTON — BOARD OF PUBLIC WORKS

SEWER DIVISION

Sketch of Service Here **231**

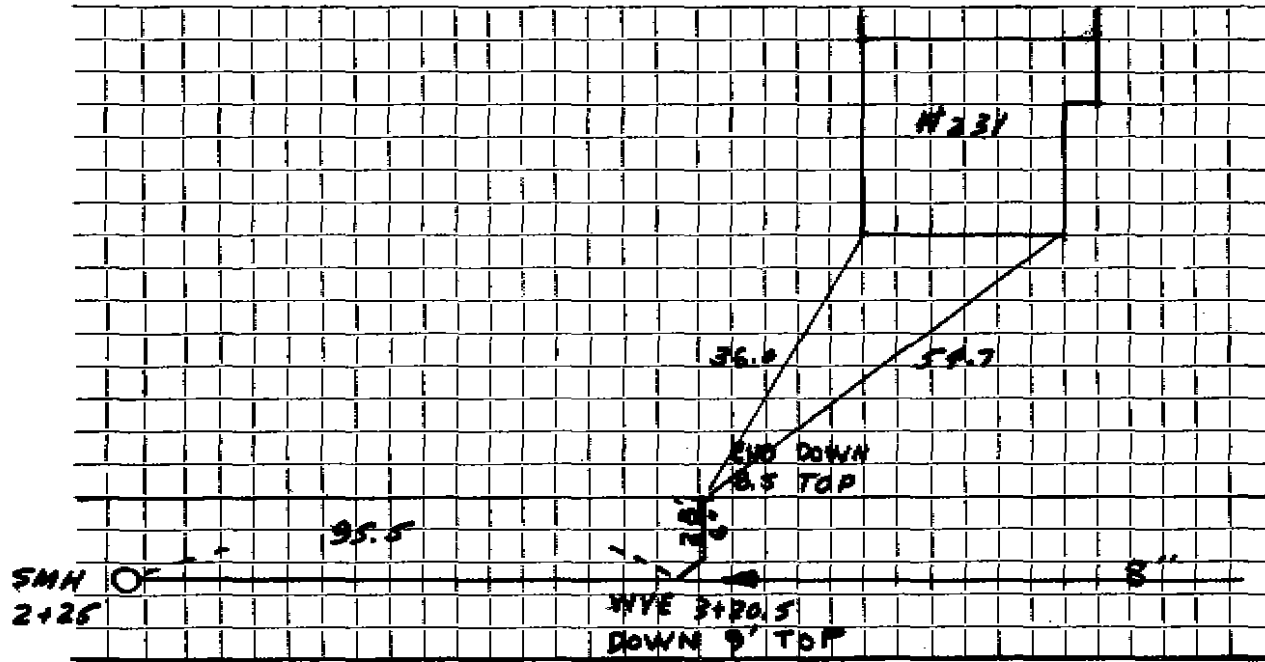

Connection made in Street. Work completed

Remarks:

.....

.....