

Name Leo Najarian

Service No. 76 (74)

Address 234 WOBURN ST.

234 Woburn Street

Location

Kind of Pipe

Size 6" A.C.

Size of Main 8"

Repair—Renewal—New Service Valeri #2537


Location AUG 16 1976

Date	Material	Amount	Total	Date	Amount	
5-21-73	26' 6" A.C. @ \$900	\$23400		8/8/74	Deposit	234.00
10/9/74	45' 6" Transite Pipe					
	6' 4" Cast Iron Pipe					

DATE _____

TOWN OF LEXINGTON — BOARD OF PUBLIC WORKS
SEWER DIVISION

Sketch of Service Here **234**

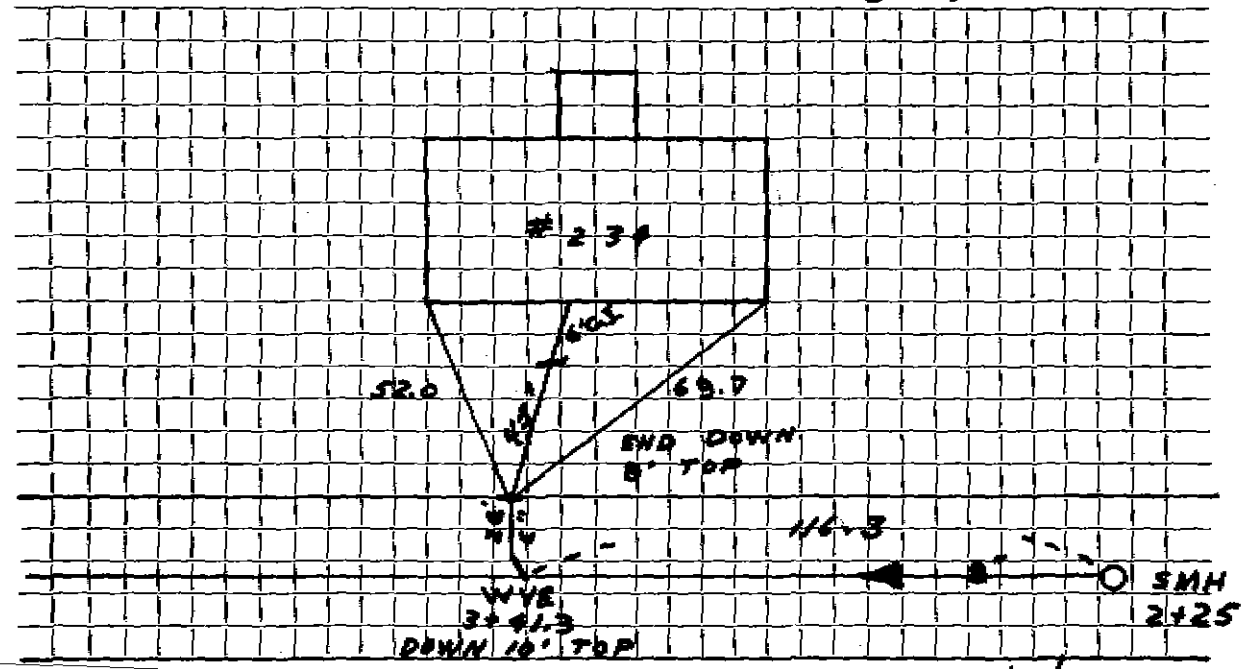

Connection made in .. 234 Woburn .. Street. Work completed .. 10/9/74 ..

Remarks: ..
.....
.....