

Name Robert Fogg

Service No. 43

Address 239 WOBURN ST.

239 Woburn Street

Location

Kind of Pipe

Size 6" A.C.

Size of Main 8"

Service ~~Reconnect~~ - New Service Redmond #4039

Location FEB 22 1982


Date	Material	Amount	Total	Date	Deposit	Amount
5-21-73	216' 6" A.C. @ \$2.00	7216.00		11-10-81	Deposit	216.00
11/10/81	66.6'	6" P.V.C.				
	2	6" P.V.C. 45° Bends				
		4" to 6" Donut				

DATE _____

TOWN OF LEXINGTON — BOARD OF PUBLIC WORKS

SEWER DIVISION

Sketch of Service Here **239**

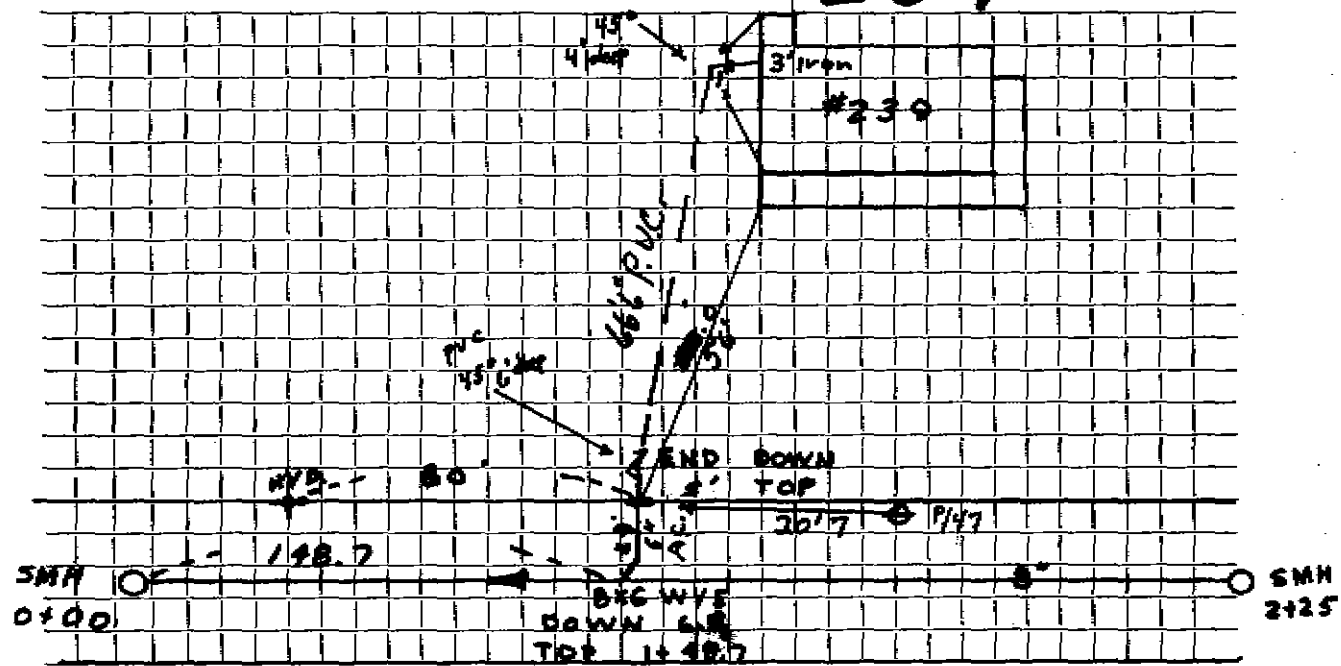

Connection made in Street. Work completed

Remarks:
.....
.....