


DATE _____

TOWN OF LEXINGTON — BOARD OF PUBLIC WORKS
SEWER DIVISION

Woburn St. Sketch of Service Here

245

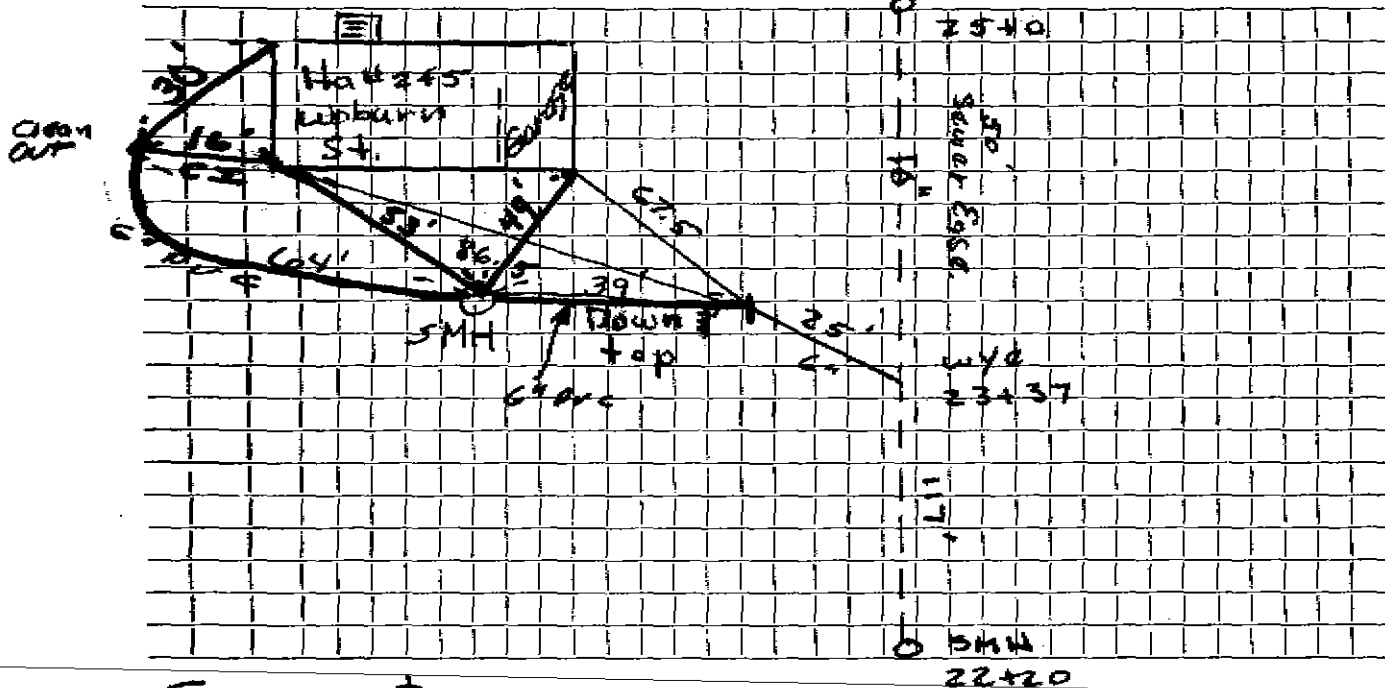

Connection made in Easement..... Street. Work completed

Remarks:
.....
.....