

Name Artie Barsamian

Service No. 35 (75)

Address 253 Woburn St.

253 Woburn STREET

Location

Kind of Pipe ACP

Size 6"

Size of Main 10"

Repair—Renewal—New Service

Ferrari Plumbing and Heating #2638

Location

AUG 16 1976

Date		Material	Amount	Total	Date		Amount
9-12	73	25' @ 9.00	\$ 225. 00		5/8/75	Deposit.	225 00
5/12/75	70	6" Transite Pipe					
	10	4" Cast Iron Pipe					


DATE \_\_\_\_\_

TOWN OF LEXINGTON — BOARD OF PUBLIC WORKS

SEWER DIVISION

253

Sketch of Service Here

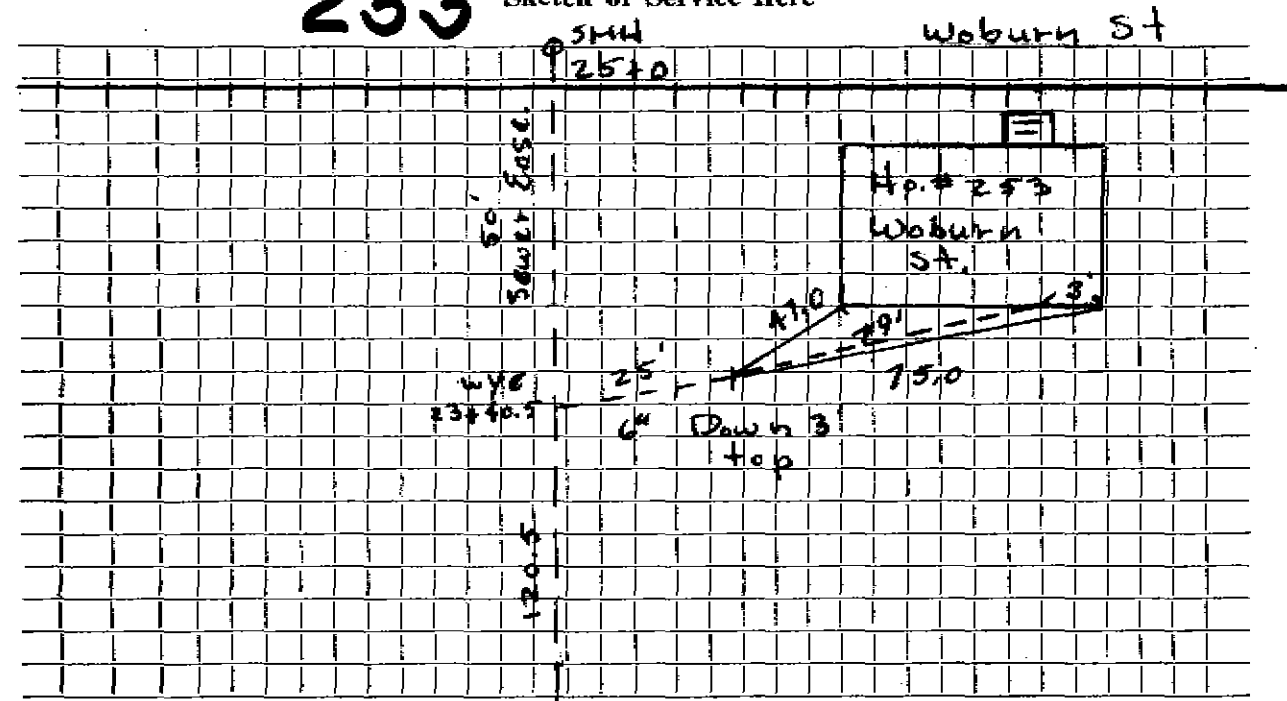

Connection made in Easement 253 Woburn St Street 22+20 Work completed 5/12/15

Remarks: .....