

Name Andy Evans

Service No.

Address 262 WOBURN ST.

262 Woburn Street

Location

Kind of Pipe

Size 6" AC

Size of Main

8"

Repair—Renewal—New Service No. Scire #4680

Location


Date	Material	Amount	Total	Date		Amount
5-17-73	24' 6" AC @ \$9.00	\$216.00		6-8-88	Deposit	216.00
6/17 88	39' 6" PVC.					
	① Wye					
	① 2' - 6" PVC + Fernco. 6" 1/2"					
	① 2' - 6" PVC + " 6" 1/2"					

DATE _____

TOWN OF LEXINGTON — BOARD OF PUBLIC WORKS

SEWER DIVISION

Sketch of Service Here **262**

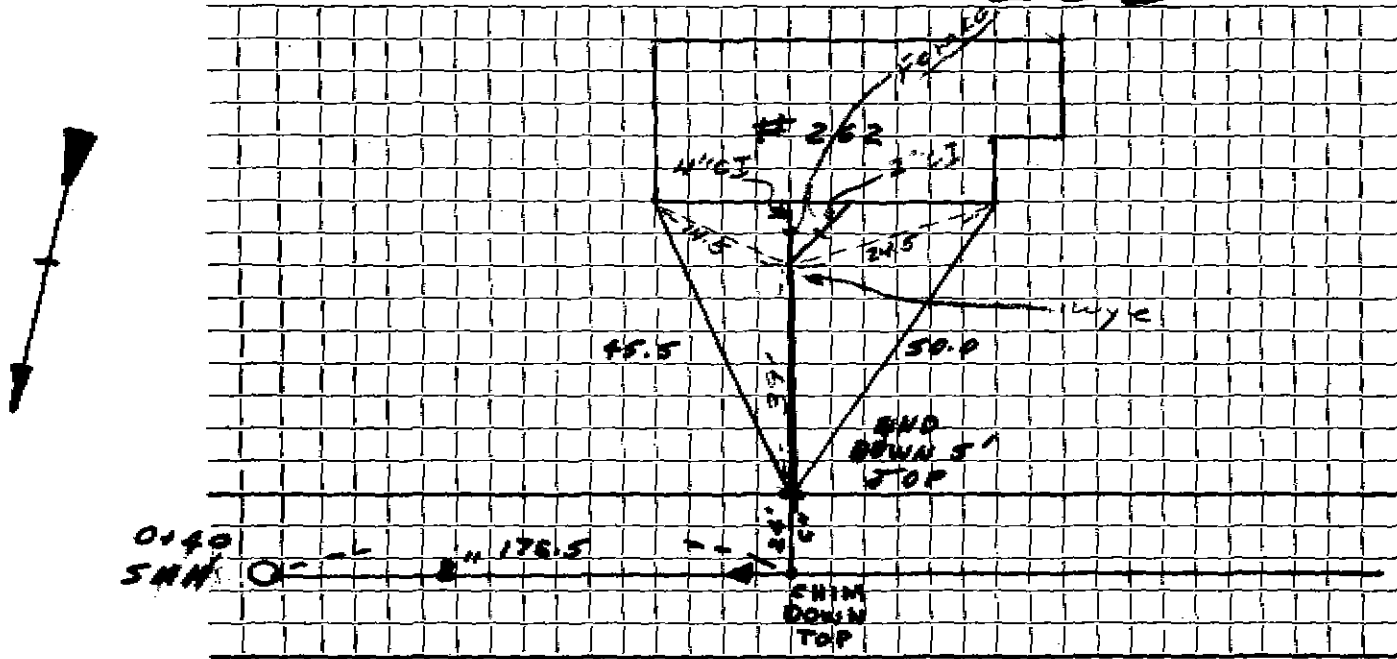

Connection made in Street. Work completed

Remarks:

.....

.....

265 Woburn
SEWER

PATIO

30'
38'

6" 6" Woburn
FERNID
45°
6" 4" Woburn
FERNID
45°

