




DATE JAN 20 1998

TOWN OF LEXINGTON — BOARD OF PUBLIC WORKS  
SEWER DIVISION

Sketch of Service Here

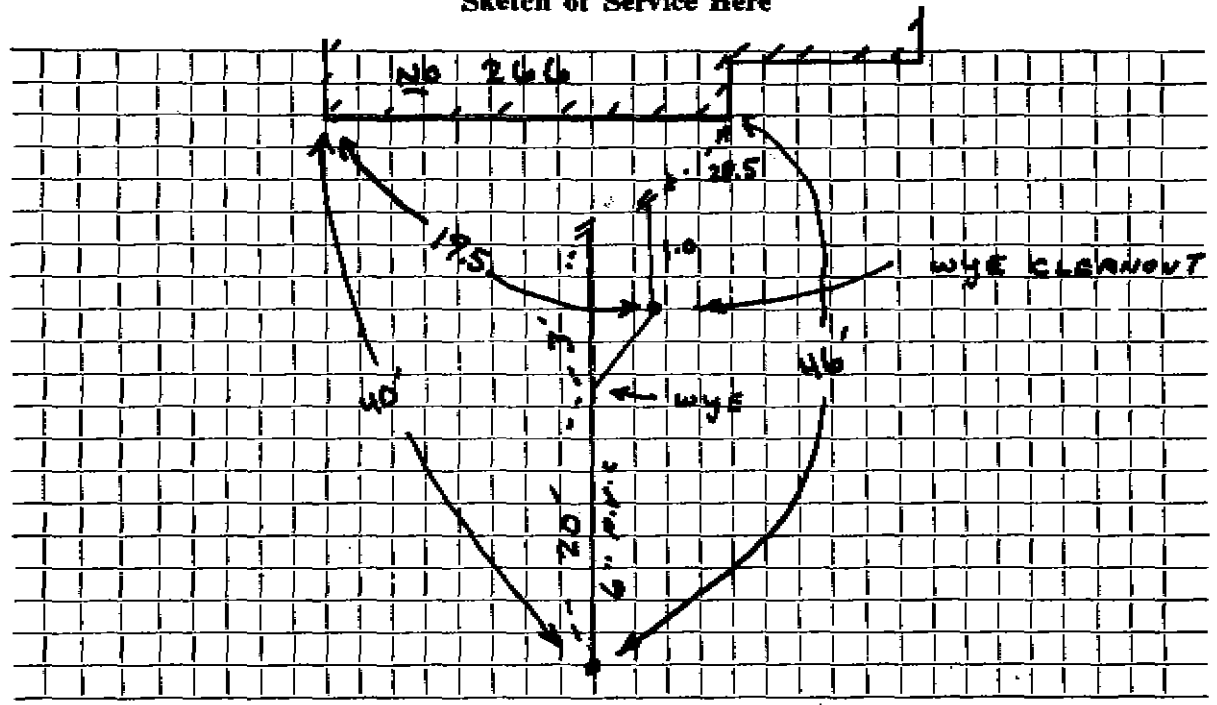

Connection made in WOBURN ST Street.

Work completed J.M. McLAUGHLIN

Remarks:

FIELD BOOK 98-1

TJM

Name

Service No.

Address 266 WOBURN ST.

266 Woburn Street

Location

Kind of Pipe

Size 6"

Size of Main 8"

Repair—Renewal—New Service

Location

Date

Material

Amount

Total

Date

Amount

5-17-73



26' 6" K. D. @ 9.00

\$234.00

DATE \_\_\_\_\_

TOWN OF LEXINGTON — BOARD OF PUBLIC WORKS  
SEWER DIVISION

Sketch of Service Here **266**

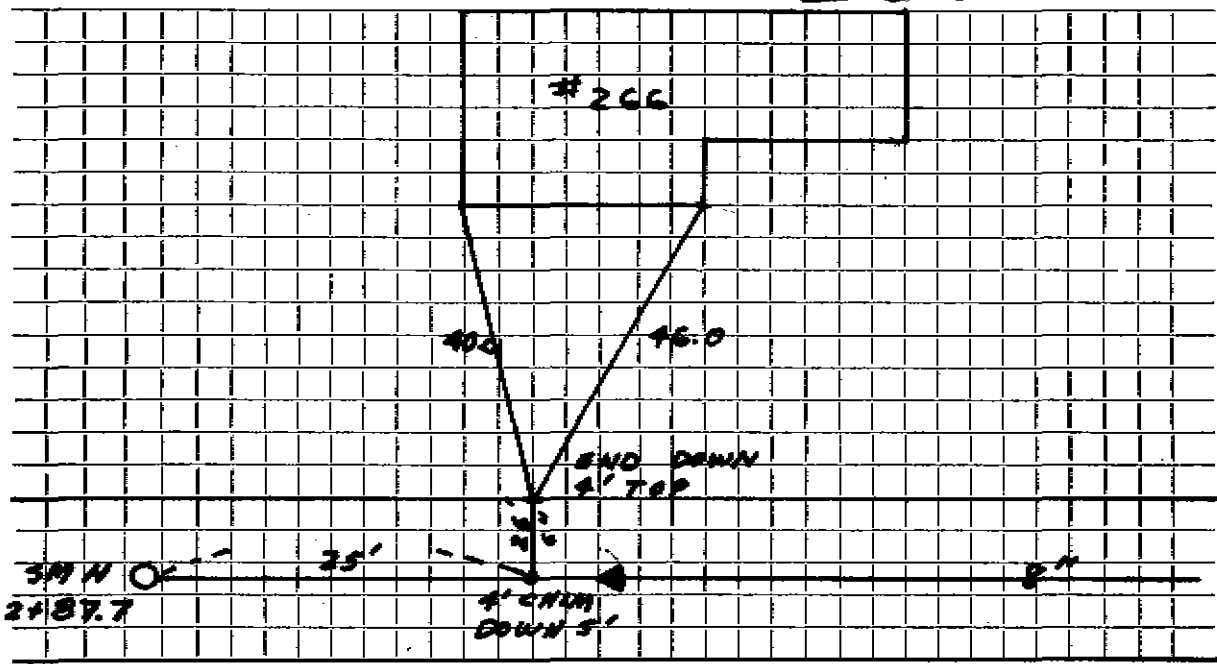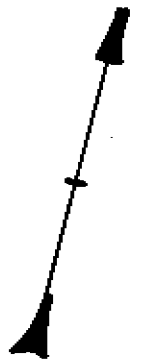

Connection made in ..... Street. Work completed .....

Remarks: .....  
.....  
.....