


TOWN OF LEXINGTON MASSACHUSETTS

Sewer Service Tie Card

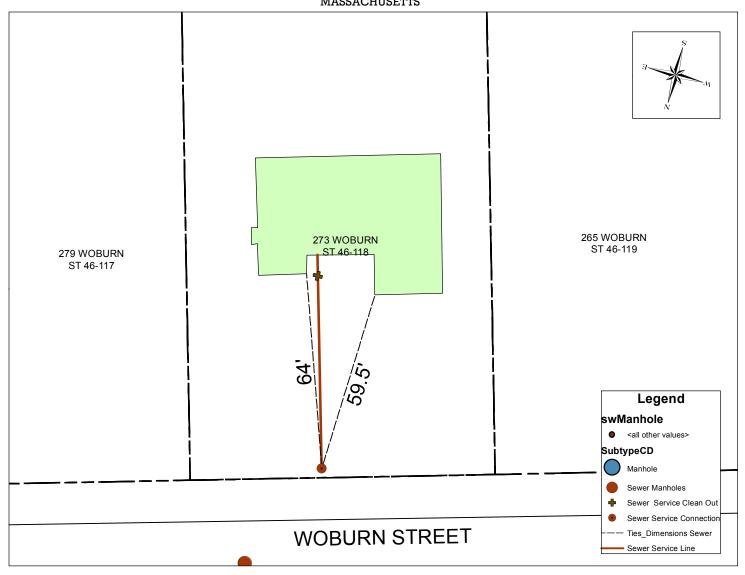

Address	Map and Lot	Permit Number	Contractor Name	Inspector
273 Woburn St	46-118	6069	McLaughlin, James M. Inc.	msprague
Date	Material	Depth of Cover	Amount	
3/19/2015	6x6 Fern Co	8 ft	1-Connect to existing stub	
	6" PVC Pipe - SDR 35		63.7 ft to Clean out	
	PVC Clean out		12 ft to HSE	
Type of work completed				

New 6" PVC sewer service installed to new house, connection to existing stub at main.